## CR-19-103 **CORNER RECORD** Agency Index **Document Number** City of County of California San Joaquin Brief Legal Description Southwest Corner of Parcel "1" per P.M. 25-68, S.J.C.R. & SJCO BM YX-44 **CORNER TYPE COORDINATES (Optional)** Government Corner Control Elevation U.S. Survey Foot Meander **Property** Units Metric Rancho Other Horizontal Datum Zone Epoch Date Date of Survey NGVD 29 July 27, 2019 Vertical Datum Complies with Public Resources Code §§8801-8819 Sec. 18, T.3S., R.6E., M.D.B. & M. Complies with Public Resources Code §§8890-8902 PLS Act Ref.: **X** 8771 8765(d) 8773 Other: Left as found Established Rebuilt **Pre-Construction** Corner/ Monument: Found and tagged Reestablished Referenced Post-Construction Narrative of corner identified and monument as found, set, reset, replaced, or removed: ✓ See sheet #2 for description(s): **SURVEYOR'S STATEMENT**

		9	100 de	
This Corner Record	was prepared by me	or under my dire	ction in confe	ormance with

the Professional Land Surveyors' Act on



**COUNTY SURVEYOR'S STATEMENT** 

This Corner Record was received

August 30, 2019

and examined and filed


Signed

P.L.S. 0<del>r R.C.E</del>. No. **8657** 

Title

**County Surveyor's Comment** 



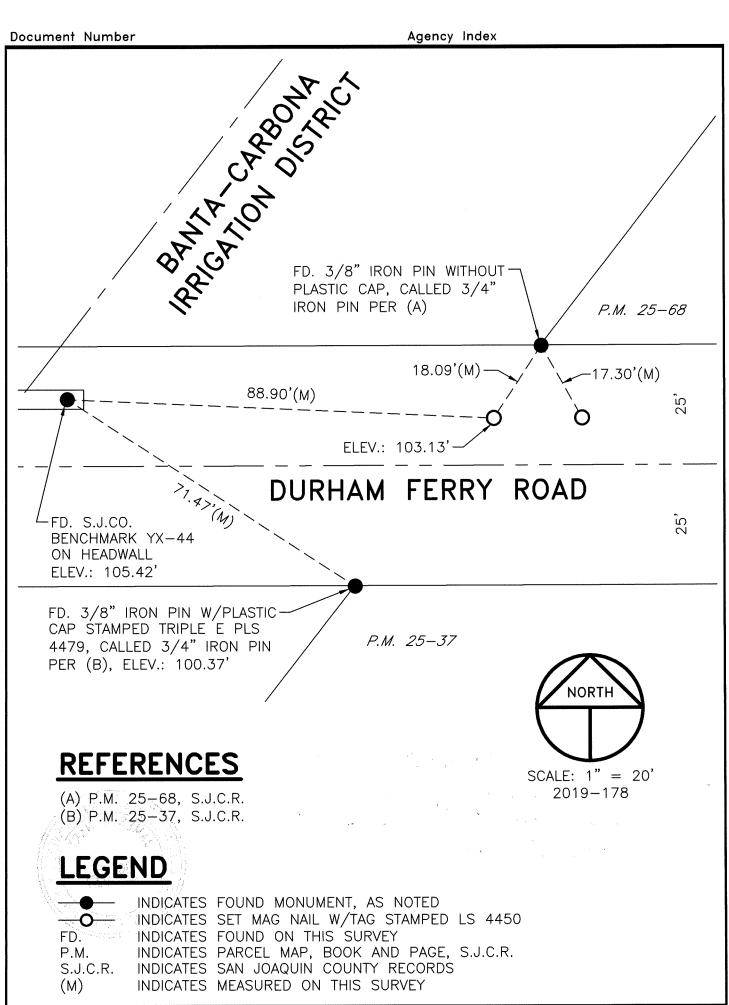

PAGE 2 OF 2 BPFLSG-2016