

CORNER RECORD


Agency Index CR-19-104
Document Number _____

City of _____ County of San Joaquin, California

Brief Legal Description South line of Parcel "2" per P.M. 20-51, S.J.C.R.

CORNER TYPE

COORDINATES (Optional)

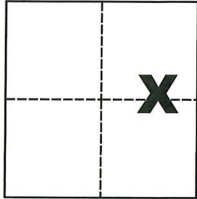

Government Corner Control
Meander Property
Rancho Other

N. _____ E. _____
Elevation _____
Units Metric U.S. Survey Foot
Horizontal Datum _____
Zone _____ Epoch Date _____
Vertical Datum _____

Date of Survey July 26, 2019

Sec. 25, T.2S., R.5E.,
M.D.B. & M.

Complies with Public Resources Code §§8801-8819
 Complies with Public Resources Code §§8890-8902

PLS Act Ref.:	<input checked="" type="checkbox"/> 8765(d)	<input type="checkbox"/> 8771	<input type="checkbox"/> 8773	<input type="checkbox"/> Other:
Corner/ Monument:	<input checked="" type="checkbox"/> Left as found	<input type="checkbox"/> Established	<input type="checkbox"/> Rebuilt	<input type="checkbox"/> Pre-Construction
	<input type="checkbox"/> Found and tagged	<input type="checkbox"/> Reestablished	<input checked="" type="checkbox"/> Referenced	<input type="checkbox"/> Post-Construction

Narrative of corner identified and monument as found, set, reset, replaced, or removed:

See sheet #2 for description(s):

Set a 1/2" x 30" Iron Pipe with Plastic Cap Stamped LS 4450 on property lines at a random distance.

SURVEYOR'S STATEMENT

This Corner Record was prepared by me or under my direction in conformance with
the Professional Land Surveyors' Act on Aug. 28, 2019

Signed Michael L. Quarteron P.L.S. or R.C.E. No. L.S. 4450



COUNTY SURVEYOR'S STATEMENT

This Corner Record was received August 30, 2019


and examined and filed September 13, 2019

Signed James E. Hart P.L.S. or R.C.E. No. 8657

Title County Surveyor


County Surveyor's Comment



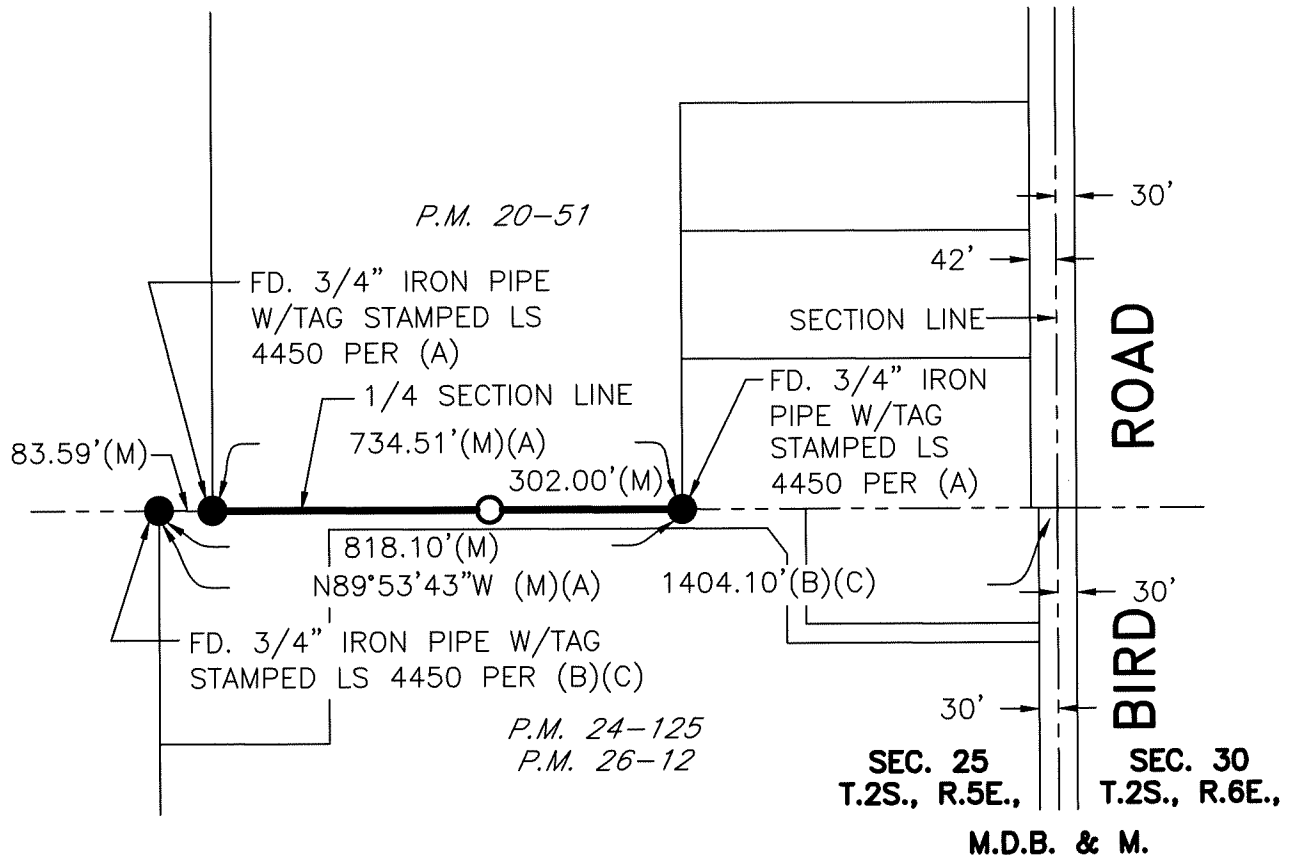

REFERENCES

- (A) P.M. 20-51, S.J.C.R.
- (B) P.M. 24-125, S.J.C.R.
- (C) P.M. 26-12, S.J.C.R.

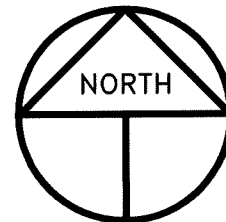

SCALE: 1" = 300'
2019-111

LEGEND

- INDICATES FOUND MONUMENT, AS NOTED
- INDICATES SET 1/2" X 30" IRON PIPE W/PLASTIC CAP STAMPED LS 4450
- FD. INDICATES FOUND ON THIS SURVEY
- P.M. INDICATES PARCEL MAP, BOOK AND PAGE, S.J.C.R.
- S.J.C.R. INDICATES SAN JOAQUIN COUNTY RECORDS