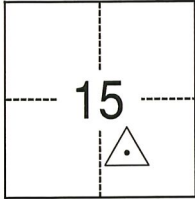


CORNER RECORD

Agency Index CR-19-119

Document Number _____

City of Stockton County of San Joaquin, CaliforniaBrief Legal Description MOST SOUTHERLY CORNER OF LOT 6, PER BOOK 25 OF MAPS AND PLATS, PAGE 108.**CORNER TYPE****COORDINATES (Optional)**

- Government Corner Control
 Meander Property
 Rancho Other

Date of Survey July 19, 2019

N. _____ E. _____

Elevation _____

Units Metric U.S. Survey Foot

Horizontal Datum _____

Zone _____ Epoch Date _____

Vertical Datum _____

 Complies with Public Resources Code §§8801-8819 Complies with Public Resources Code §§8890-8902

T.2N., R.6E., M.D.B.&M.

PLS Act Ref.: 8765(d) 8771 8773 Other:Corner/Monument: Left as found Established Rebuilt Pre-Construction Found and tagged Reestablished Referenced Post-Construction

Narrative of corner identified and monument as found, set, reset, replaced, or removed:

 See sheet #2 for description(s):

Found 1" iron rod, down 0.2', with plastic cap marked "LS 5342"(no record), located behind the sidewalk and next to a PG&E utility box, taken as marking the most southerly corner of Lot 6 per map of Tract No. 1695, Hammertown Unit No. 4, filed in Book 25 of Maps and Plats, at Page 108, San Joaquin County Records.

Set new ties; see reverse for details.

SURVEYOR'S STATEMENT

This Corner Record was prepared by me or under my direction in conformance with

the Professional Land Surveyors' Act on September 18, 2019Signed Scott J. Roberts (P.L.S. or R.C.E. No. 9235)**COUNTY SURVEYOR'S STATEMENT**This Corner Record was received September 19, 2019and examined and filed October 3, 2019Signed James E. Hart P.L.S. or R.C.E. No. 8657Title County Surveyor

County Surveyor's Comment _____




LEGEND:

MONUMENT TIE LINE	-----
CURB	=====
MP	-----
LOT LINE	-----
CENTERLINE	-----

REFERENCE:

(R1) 25-MP-108, SAN JOAQUIN COUNTY RECORDS

MAPS AND PLATS

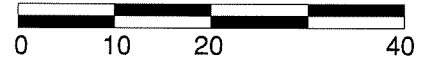

SCALE: 1" = 20'

