## **CORNER RECORD**


CR-19-122 **Document Number** , California City of County of San Joaquin Brief Legal Description E. line of Parcels 1, 2.A and 2.B per Unfiled Survey by Chas. H. Widdows dated Sept. 1929, File No. 237-SS **CORNER TYPE COORDINATES (Optional)** N. Government Corner Control Elevation U.S. Survey Foot Meander **Property** Units Other Rancho Horizontal Datum Epoch Date Zone Date of Survey August 13, 2019 Vertical Datum Complies with Public Resources Code §§8801-8819 Sec. 15 and 16, T.3N., R.5E., M.D.B. & M. Complies with Public Resources Code §§8890-8902 8765(d) PLS Act Ref.: 8771 8773 Other: Left as found Established Rebuilt **Pre-Construction** Corner/ Monument: Found and tagged Referenced Reestablished Post-Construction Narrative of corner identified and monument as found, set, reset, replaced, or removed: ✓ See sheet #2 for description(s): SURVEYOR'S STATEMENT This Corner Record was prepared by me or under my direction in conformance with **COUNTY SURVEYOR'S STATEMENT** Peptember 25, 2019 This Corner Record was received and examined and filed Signed Title

Page 1 of 2

Agency Index

Job No.: 2015-117

**County Surveyor's Comment** 

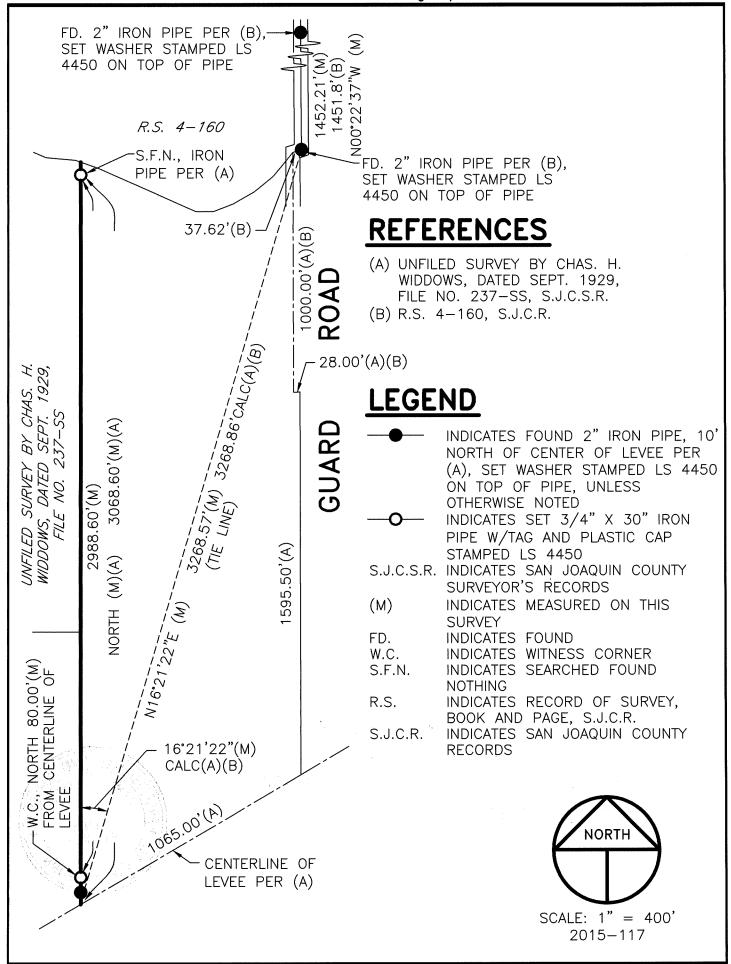

BPELSG-2016 PAGE 2 OF 2