


# CORNER RECORD

Agency Index: CR-19-127

Document Number: \_\_\_\_\_

City of LODI County of SAN JOAQUIN, California

Brief Legal Description MONUMENTS ALONG LOCKEFORD STREET AT MAIN STREET. LOCATED IN THE EAST HALF OF SECTION 1, T.3 N., R.6 E., MOUNT DIABLO BASE AND MERIDIAN.

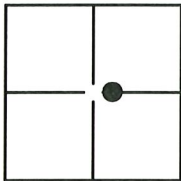

SEC. 1  
T.3N, R.6E

### CORNER TYPE

- Government Corner  Control
- Meander  Property
- Rancho  Other

Date of Survey 09-10-2019

### COORDINATES (Optional)

N. \_\_\_\_\_ E. \_\_\_\_\_  
 Elevation: \_\_\_\_\_  
 Units Metric  U.S. Survey Foot   
 Horizontal Datum: \_\_\_\_\_  
 Zone: \_\_\_\_\_ Epoch Date: \_\_\_\_\_  
 Vert. Datum: \_\_\_\_\_

- Complies with Public Resources Code §§8801-8819
- Complies with Public Resources Code §§8890-8902

PLS Act Ref:  8765(d)  8771  8773  Other:

Corner/  
 Monument:  Left as found  Established  Rebuilt  Pre-Construction  
 Found and Tagged  Reestablished  Referenced  Post-Construction

Narrative of corner identified and monument as found, set, reset, replaced, or removed:

See sheet #2 for description(s):

1-1/4" BRASS WASHER & PIN STAMPED "ELSON LS 7889" WAS REMOVED DURING CONSTRUCTION AND REPLACED WITH A 3/4" X 24" IRON PIPE TAGGED "LS 6953", ALL AS SHOWN ON PAGE 2.


### SURVEYOR'S STATEMENT

This Corner Record was prepared by me or under my direction in conformance with the Professional Land Surveyors' Act on SEPTEMBER 30, 2019,  
 Signed [Signature] P.L.S. or R.C.E. Number 6953



### COUNTY SURVEYOR'S STATEMENT

This Corner Record was received October 25, 2019  
 and examined and filed November 6, 2019  
 Signed James E. Hart P.L.S. or R.C.E. No: 8657  
 Title County Surveyor

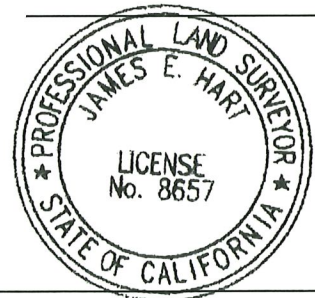

County Surveyor's Comment \_\_\_\_\_

