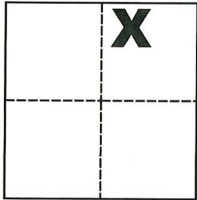


# CORNER RECORD

Agency Index CR-19-130

Document Number \_\_\_\_\_

City of \_\_\_\_\_ County of San Joaquin, CaliforniaBrief Legal Description Most Southerly corner of 54.17 Acre parcel per R.S. 33-132, S.J.C.R.**CORNER TYPE****COORDINATES (Optional)**

Government Corner  Control   
 Meander  Property   
 Rancho  Other

N. \_\_\_\_\_ E. \_\_\_\_\_

Elevation \_\_\_\_\_

Units Metric  U.S. Survey Foot 

Horizontal Datum \_\_\_\_\_

Zone \_\_\_\_\_ Epoch Date \_\_\_\_\_

Date of Survey August 19, 2019

Vertical Datum \_\_\_\_\_

 Complies with Public Resources Code §§8801-8819 Complies with Public Resources Code §§8890-8902Sec. 34, T.1S., R.5E.,  
M.D.B. & M.

PLS Act Ref.:  8765(d)  8771  8773  Other:  
 Corner/Monument:  Left as found  Established  Rebuilt  Pre-Construction  
 Found and tagged  Reestablished  Referenced  Post-Construction

Narrative of corner identified and monument as found, set, reset, replaced, or removed:



 See sheet #2 for description(s):**SURVEYOR'S STATEMENT**

This Corner Record was prepared by me or under my direction in conformance with

the Professional Land Surveyors' Act on Sept. 24, 2019Signed Michael L. Quarantaro P.L.S. or R.C.E. No. L.S. 4450**COUNTY SURVEYOR'S STATEMENT**This Corner Record was received November 1, 2019and examined and filed December 5, 2019Signed James E. Hart P.L.S. or R.C.E. No. 8657Title County Surveyor

County Surveyor's Comment \_\_\_\_\_



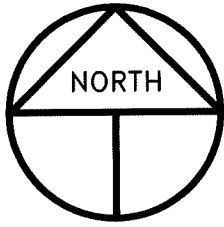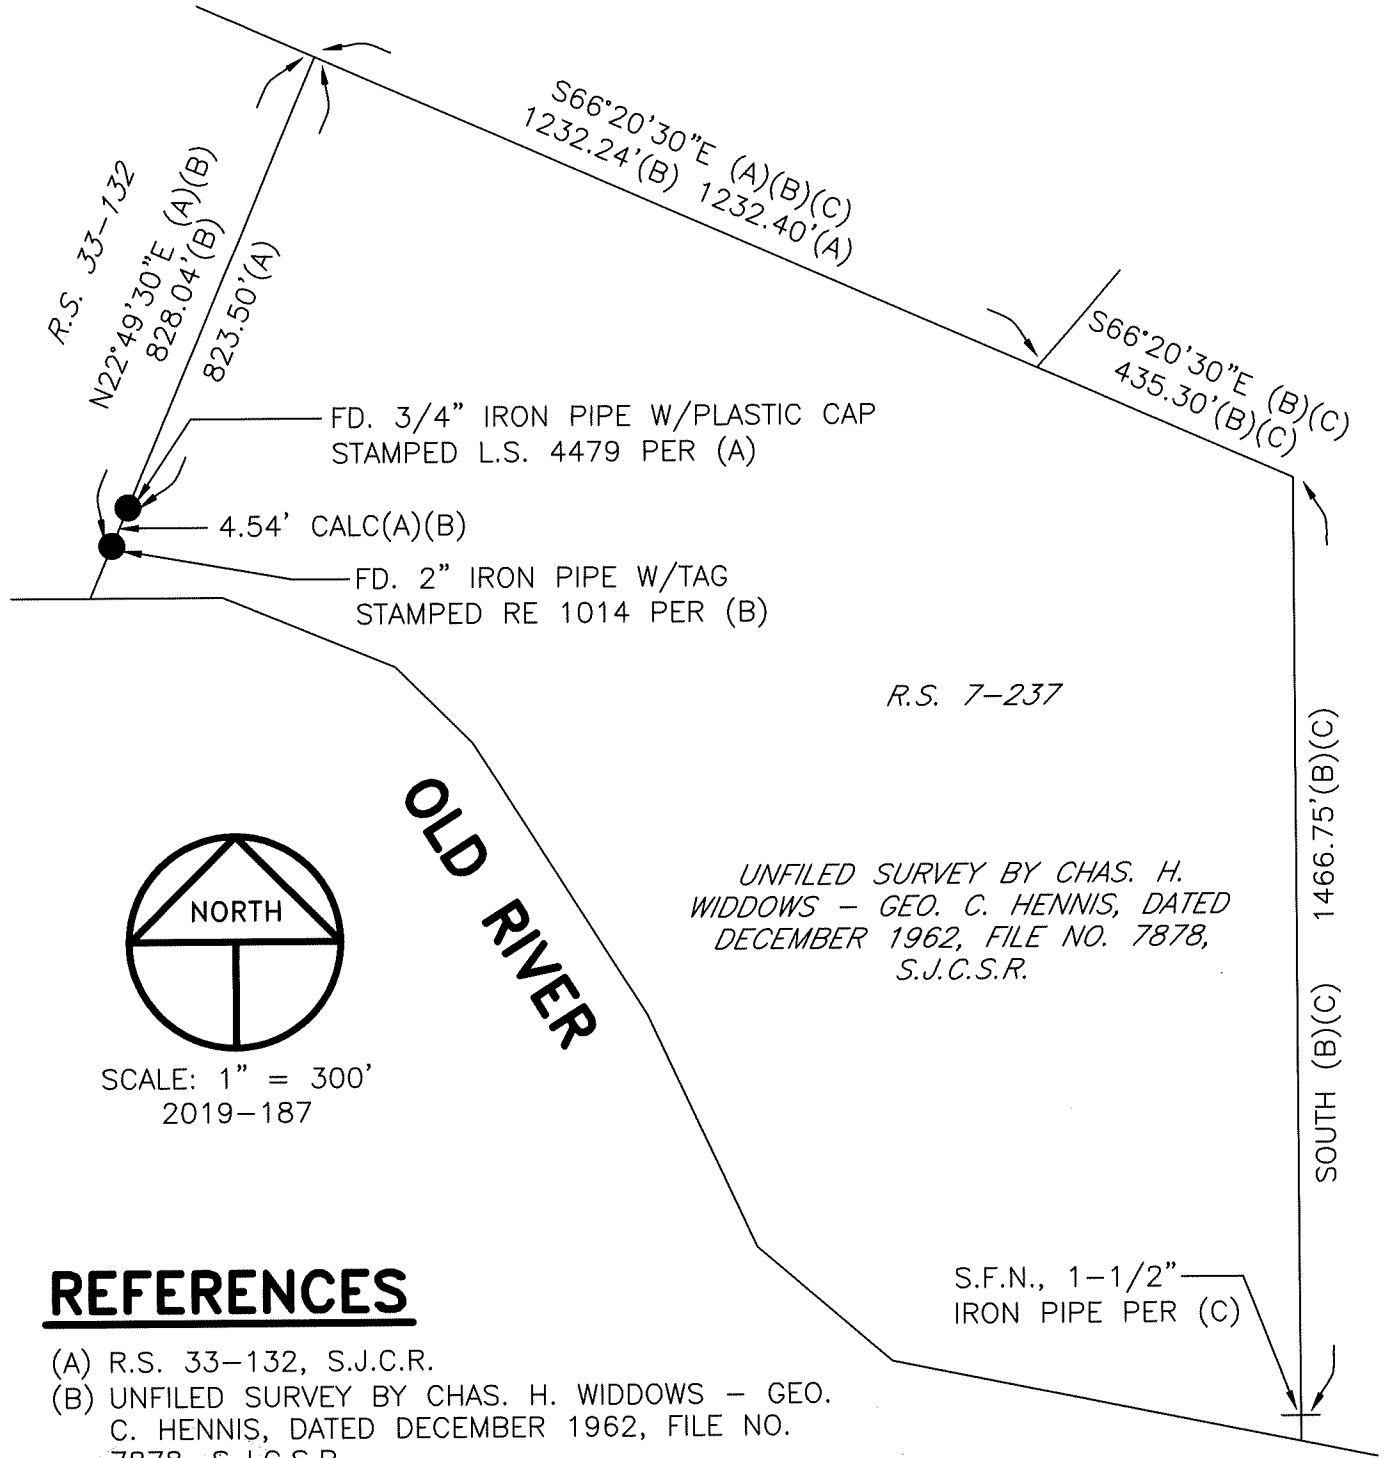

SCALE: 1" = 300'  
2019-187

UNFILED SURVEY BY CHAS. H. WIDDOWS - GEO. C. HENNIS, DATED DECEMBER 1962, FILE NO. 7878, S.J.C.S.R.

**REFERENCES**

- (A) R.S. 33-132, S.J.C.R.
- (B) UNFILED SURVEY BY CHAS. H. WIDDOWS - GEO. C. HENNIS, DATED DECEMBER 1962, FILE NO. 7878, S.J.C.S.R.
- (C) R.S. 7-237, S.J.C.R.

**LEGEND**

- INDICATES FOUND MONUMENT AS NOTED
- FD. INDICATES FOUND
- R.S. INDICATES RECORD OF SURVEY, BOOK AND PAGE, S.J.C.R.
- S.J.C.R. INDICATES SAN JOAQUIN COUNTY RECORDS
- S.J.C.S.R. INDICATES SAN JOAQUIN COUNTY SURVEYOR'S RECORDS
- S.F.N. INDICATES SEARCHED FOUND NOTHING