
## CORNER RECORD

Agency Index **Document Number** County of City of Lodi San Joaquin California Brief Legal Description Northeast Corner of Lot 326 and Southeast Corner of Lot 309, per M. & P. 23-23, S.J.C.R. **CORNER TYPE COORDINATES (Optional)** N. Government Corner Control Elevation Meander Property Units Metric \_\_\_\_ U.S. Survey Foot X Rancho Other Horizontal Datum Epoch Date Zone Date of Survey August 28, 2019 Vertical Datum Complies with Public Resources Code §§8801-8819 Sec. 14, T.3N., R.6E., M.D.B. & M. Complies with Public Resources Code §§8890-8902 PLS Act Ref.: 8765(d) X 8771 8773 Other: Left as found Established Rebuilt **Pre-Construction** Corner/ Monument: Found and tagged Reestablished Referenced Post-Construction Narrative of corner identified and monument as found, set, reset, replaced, or removed: ✓ See sheet #2 for description(s): **SURVEYOR'S STATEMENT** This Corner Record was prepared by me or under my direction in conformance with the Professional Land Surveyors' Act on P.L.S. or R.C.E. No. L.S. 4450 **COUNTY SURVEYOR'S STATEMENT** November 1, 2019 This Corner Record was received December 5, 2019


Had P.L.S. OFR.G.E. No. 8657 and examined and filed Signed Title


(D.D. Sheet No. 15) BPELSG-2016

**County Surveyor's Comment** 

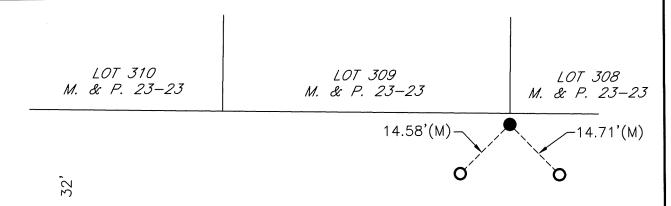

## WIMBLEDON DRIVE

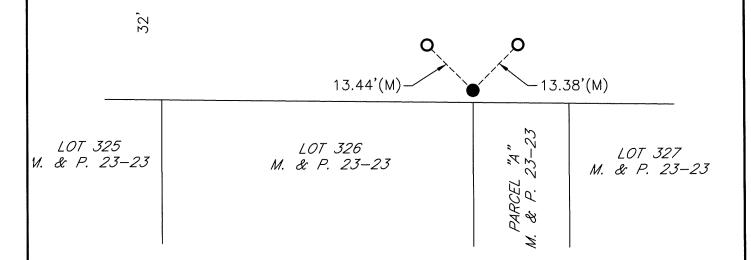

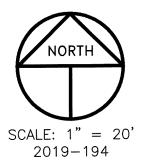

## **LEGEND**

INDICATES FOUND CHISELED CROSS, NO REFERENCE, CHISELED CROSS IS VERY LARGE AND CRUDE, EXISTING SIDEWALK IS VERY ERODED

M. & P. INDICATES MAPS AND PLATS, VOLUME AND PAGE, S.J.C.R.

S.J.C.R. INDICATES SAN JOAQUIN COUNTY RECORDS (M) INDICATES MEASURED ON THIS SURVEY