


CORNER RECORD

Agency Index CR-19-139
Document Number _____

City of Stockton County of San Joaquin, California

Brief Legal Description Southwest Corner of Lot 124 per M. & P. 26-61, S.J.C.R.

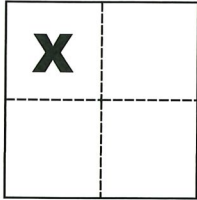

CORNER TYPE

- Government Corner Control
- Meander Property
- Rancho Other

COORDINATES (Optional)

- N. _____ E. _____
- Elevation _____
- Units Metric U.S. Survey Foot
- Horizontal Datum _____
- Zone _____ Epoch Date _____
- Vertical Datum _____

Sec. 14, T.2N., R.6E.,
M.D.B. & M.

- Complies with Public Resources Code §§8801-8819
- Complies with Public Resources Code §§8890-8902

- PLS Act Ref.: 8765(d) 8771 8773 Other:
- Corner/Monument: Left as found Established Rebuilt Pre-Construction
- Found and tagged Reestablished Referenced Post-Construction

Narrative of corner identified and monument as found, set, reset, replaced, or removed:

See sheet #2 for description(s):

SURVEYOR'S STATEMENT

This Corner Record was prepared by me or under my direction in conformance with

the Professional Land Surveyors' Act on Oct. 30, 2019

Signed Michael L. Quartaroli P.L.S. or R.C.E. No. L.S. 4450



COUNTY SURVEYOR'S STATEMENT

This Corner Record was received November 1, 2019


and examined and filed December 5, 2019

Signed James E. Hart P.L.S. or R.C.E. No. 8657

Title County Surveyor

County Surveyor's Comment



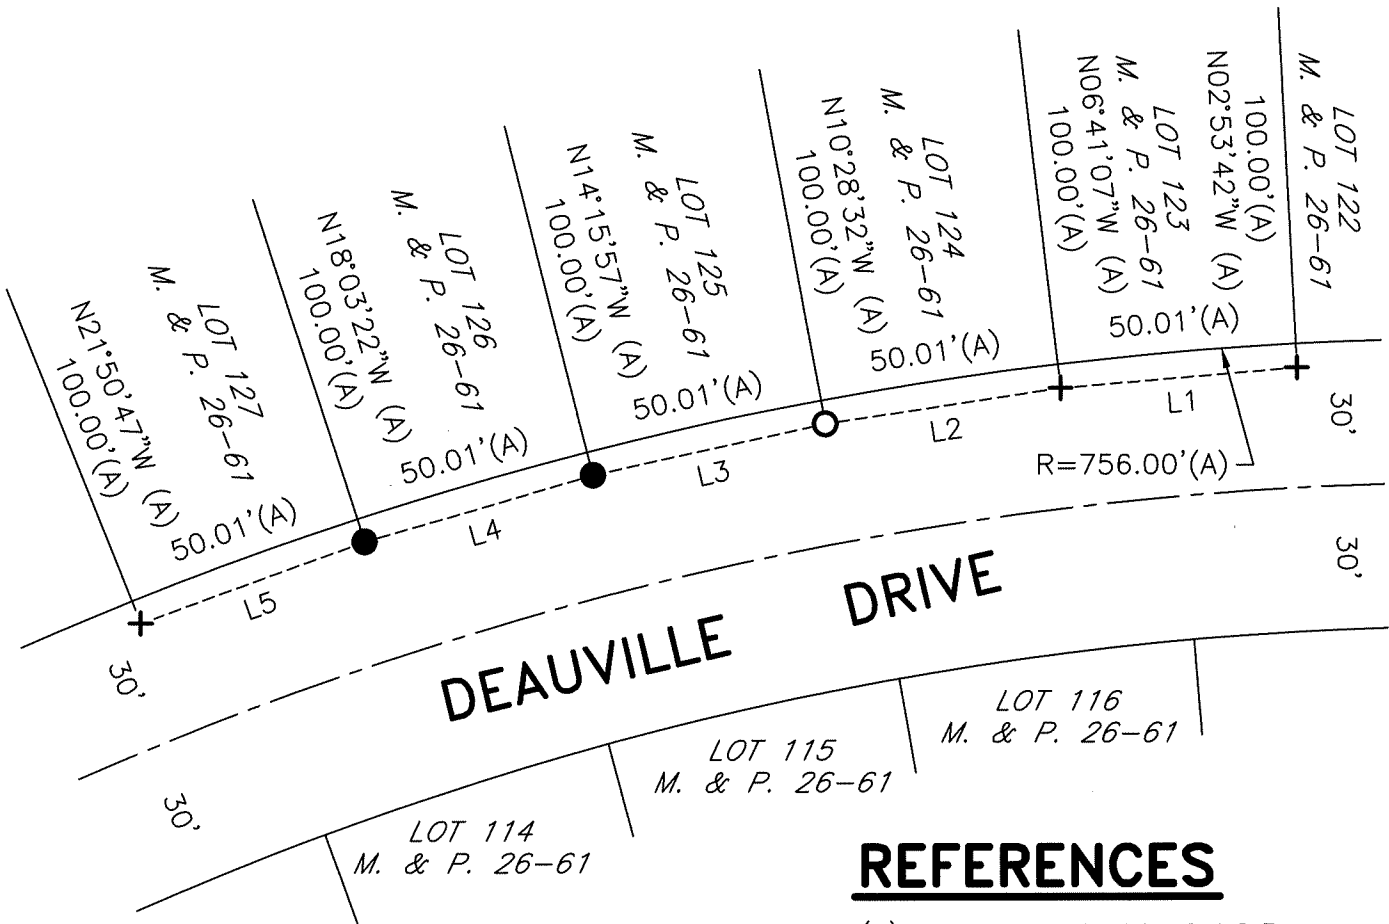


LINE TABLE

LINE	BEARING	DISTANCE
L1	S85°12'36"W (M) CALC(A)	49.68'(M) CALC(A)
L2	S81°25'10"W (M) CALC(A)	49.68'(M) CALC(A)
L3	S77°37'46"W (M) CALC(A)	49.68'(M) CALC(A)
L4	S73°50'20"W (M) CALC(A)	49.68'(M) CALC(A)
L5	S70°02'56"W (M) CALC(A)	49.68'(M) CALC(A)

REFERENCES

- (A) M. & P. 26-61, S.J.C.R.
- (B) C.R.-16-132, S.J.C.S.R.

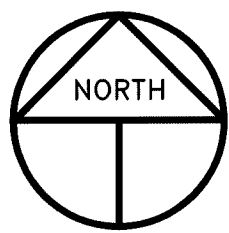

SCALE: 1" = 40'
2019-214

LEGEND

- INDICATES FOUND 1" BRASS DISC STAMPED LS 6947 ALONG THE PROJECTED LOT LINE, 5.00'(M) FROM LOT CORNER PER (B)
- ⊕ INDICATES FOUND WITNESS CORNER CHISELED CROSS ALONG THE PROJECTED LOT LINE, 5.00'(M) FROM LOT CORNER, NO REFERENCE, NO RECORD
- INDICATES SET CHISELED CROSS ALONG THE PROJECTED LOT LINE, 5.00'(M) FROM LOT CORNER
- FD. INDICATES FOUND ON THIS SURVEY
- (M) INDICATES MEASURED ON THIS SURVEY
- (R) INDICATES RADIAL BEARING
- M. & P. INDICATES MAPS AND PLATS, VOLUME AND PAGE, S.J.C.R.
- C.R. INDICATES CORNER RECORD, S.J.C.S.R.
- S.J.C.R. INDICATES SAN JOAQUIN COUNTY RECORDS
- S.J.C.S.R. INDICATES SAN JOAQUIN COUNTY SURVEYOR'S RECORDS