


# CORNER RECORD

Agency Index CR-19-140

Document Number \_\_\_\_\_

City of Stockton County of San Joaquin, California

Brief Legal Description Northerly corner of Lot 255 per M. & P. 25-36, S.J.C.R.

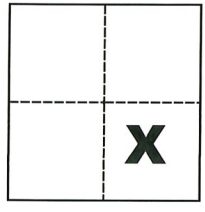

### CORNER TYPE

### COORDINATES (Optional)

- Government Corner  Control
- Meander  Property
- Rancho  Other

N. \_\_\_\_\_ E. \_\_\_\_\_  
 Elevation \_\_\_\_\_  
 Units Metric  U.S. Survey Foot   
 Horizontal Datum \_\_\_\_\_  
 Zone \_\_\_\_\_ Epoch Date \_\_\_\_\_  
 Vertical Datum \_\_\_\_\_

Date of Survey September 27, 2019

Sec. 14, T.2N., R.6E.,  
M.D.B. & M.

- Complies with Public Resources Code §§8801-8819
- Complies with Public Resources Code §§8890-8902

- PLS Act Ref.:  8765(d)  8771  8773  Other:
- Corner/Monument:  Left as found  Established  Rebuilt  Pre-Construction
- Found and tagged  Reestablished  Referenced  Post-Construction

Narrative of corner identified and monument as found, set, reset, replaced, or removed:  
 See sheet #2 for description(s):

### SURVEYOR'S STATEMENT

This Corner Record was prepared by me or under my direction in conformance with  
 the Professional Land Surveyors' Act on Oct. 30, 2019  
 Signed Michael L. Quarantoli P.L.S. or R.C.E. No. L.S. 4450




### COUNTY SURVEYOR'S STATEMENT

This Corner Record was received November 1, 2019  
 and examined and filed December 5, 2019  
 Signed James E. Hart P.L.S. or R.C.E. No. 8657  
 Title County Surveyor



County Surveyor's Comment

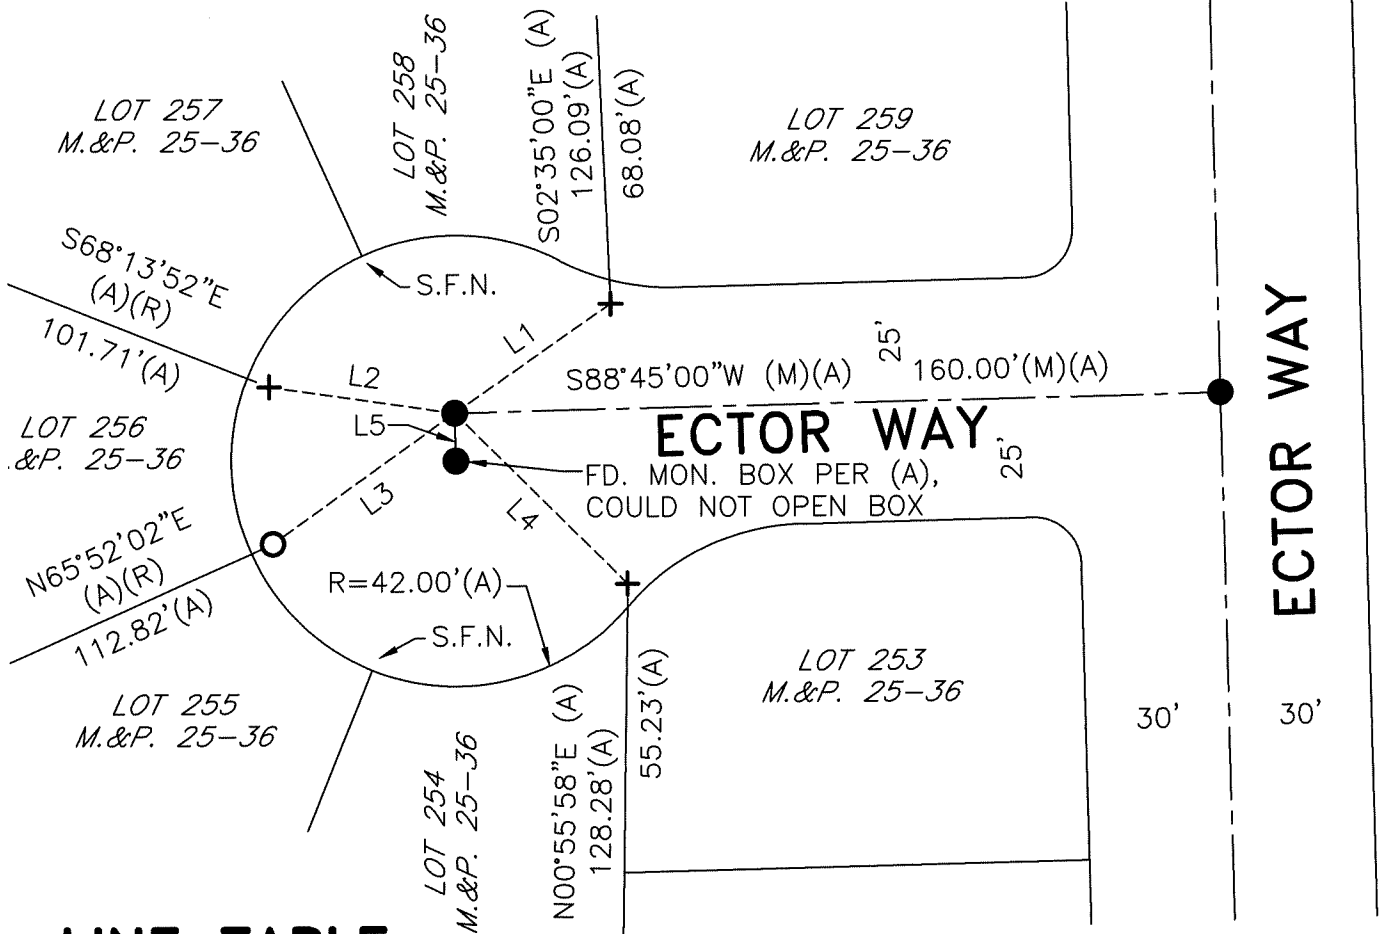


**LINE TABLE**

LINE	BEARING		DISTANCE	
L1	N55°09'45"E (M)	CALC(A)	39.67'(M)	CALC(A)
L2	N81°48'37"W (M)	CALC(A)	39.19'(M)	CALC(A)
L3	S54°31'33"W (M)	CALC(A)	46.80'(M)	CALC(A)
L4	S45°06'44"E (M)	CALC(A)	50.62'(M)	CALC(A)
L5	S01°15'00"E (A)		10.00'(A)	

**REFERENCE**

(A) M. & P. 25-36, S.J.C.R.

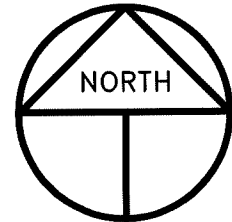

SCALE: 1" = 40'  
2019-198

**LEGEND**

- INDICATES FOUND 3/4" IRON PIN W/TAG STAMPED RCE 15831 IN MON. BOX PER (A), UNLESS OTHERWISE NOTED
- ⊕ INDICATES FOUND WITNESS CORNER CHISELED CROSS ALONG THE PROJECTED LOT LINE, 5.00'(M) FROM LOT CORNER, NO REFERENCE, NO RECORD
- INDICATES SET CHISELED CROSS
- FD. INDICATES FOUND ON THIS SURVEY
- (M) INDICATES MEASURED ON THIS SURVEY
- (R) INDICATES RADIAL BEARING
- M. & P. INDICATES MAPS AND PLATS, VOLUME AND PAGE, S.J.C.R.
- S.J.C.R. INDICATES SAN JOAQUIN COUNTY RECORDS
- S.F.N. INDICATES SEARCHED FOUND NOTHING