
CORNER RECORD			Agency Index Document Number	CR-20-24
City of	MANTECA	County of _	SAN JOAQ	UIN , California
				TION; S.5,T.2S,R.7E.
CORNER TYPE			COORDINATES (Optional) N E.	
5	Government C Meander Rancho	Corner Control Property Other	Elevation Units Metric Horizontal Datum	X U.S. Survey Foot
	Date of Survey <u>N</u>	ovember 26, 2018	Vertical Datum Complies with Public F	ch DateResources Code §§8801-8819 Resources Code §§8890-8902
PLS Act Ref.:	8765(d)	8771	8773	Other:
Corner/ Monument:	Left as found Found and tagged	Established Reestablished	Rebuilt Referenced	Pre-Construction Post-Construction
new sidewalk.				wo cut X's at the back of
This Corner Record was prepared by me or under my direction in conformance with				
the Professional Land Signed		_P.L.S. or R.C.E. No.	8513	CALIFORNIE OF CALIFORNIE
This Corner Record wa	s receivedanua	ary 17, 2020		1 I AM
and examined and filed January 29, 2020. Signed James E. Hant P.L.S. or R.C.E. No. 8657				
Title	ly Surveyor			LICENSE *
County Surveyor's	Comment			

D.D. SHEET NO.58A

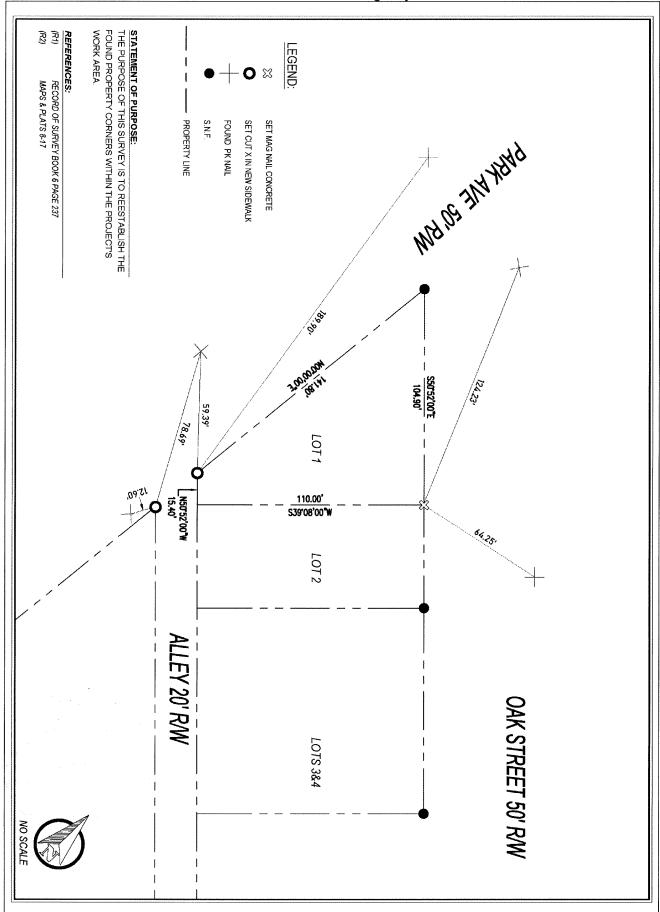

BPELSG-2016 Page 2 of 2