

CORNER RECORD

Agency Index CR-20-44


Document Number _____

City of STOCKTON

County of SAN JOAQUIN, California

Brief Legal Description MONUMENTS NEAR LOTS 598 & 599, 25-M&P-02, S.J.C.R.

CORNER TYPE		COORDINATES (Optional)	
Government Corner	<input type="checkbox"/> Control	N. _____	E. _____
Meander	<input type="checkbox"/> Property	Elevation _____	
Rancho	<input type="checkbox"/> Other	Units Metric <input type="checkbox"/> U.S. Survey Foot <input type="checkbox"/>	
	<input checked="" type="checkbox"/>	Horizontal Datum _____	
		Zone _____ Epoch Date _____	
		Vertical Datum: _____	
		<input type="checkbox"/> Complies with Public Resources Code §§8801-8819	
		<input type="checkbox"/> Complies with Public Resources Code §§8890-8902	

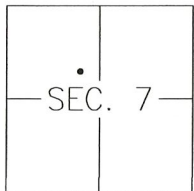

T2N/R6E

Date of Survey OCTOBER 23, 2019

PLS Act Ref.: 8765(d) 8771 8773 Other: _____

Corner/Monument: Left as found Established Rebuilt Pre-Construction
 Found and tagged Reestablished Referenced Post-Construction

Narrative of corner identified and monument as found, set, reset, replaced, or removed:
 See sheet #2 for description(s):

SURVEYOR'S STATEMENT

This Corner Record was prepared by me or under my direction in conformance with the Professional Land Surveyor's Act on JANUARY 29TH, 2020.

Signed [Signature] P.L.S. or R.C.E. No.: 8346




COUNTY SURVEYOR'S STATEMENT

This Corner Record was received February 5, 2020 and examined and filed February 27, 2020.

Signed James E. Hart P.L.S. or R.C.E. No.: 8657
 Title County Surveyor



County Surveyor's Comment _____

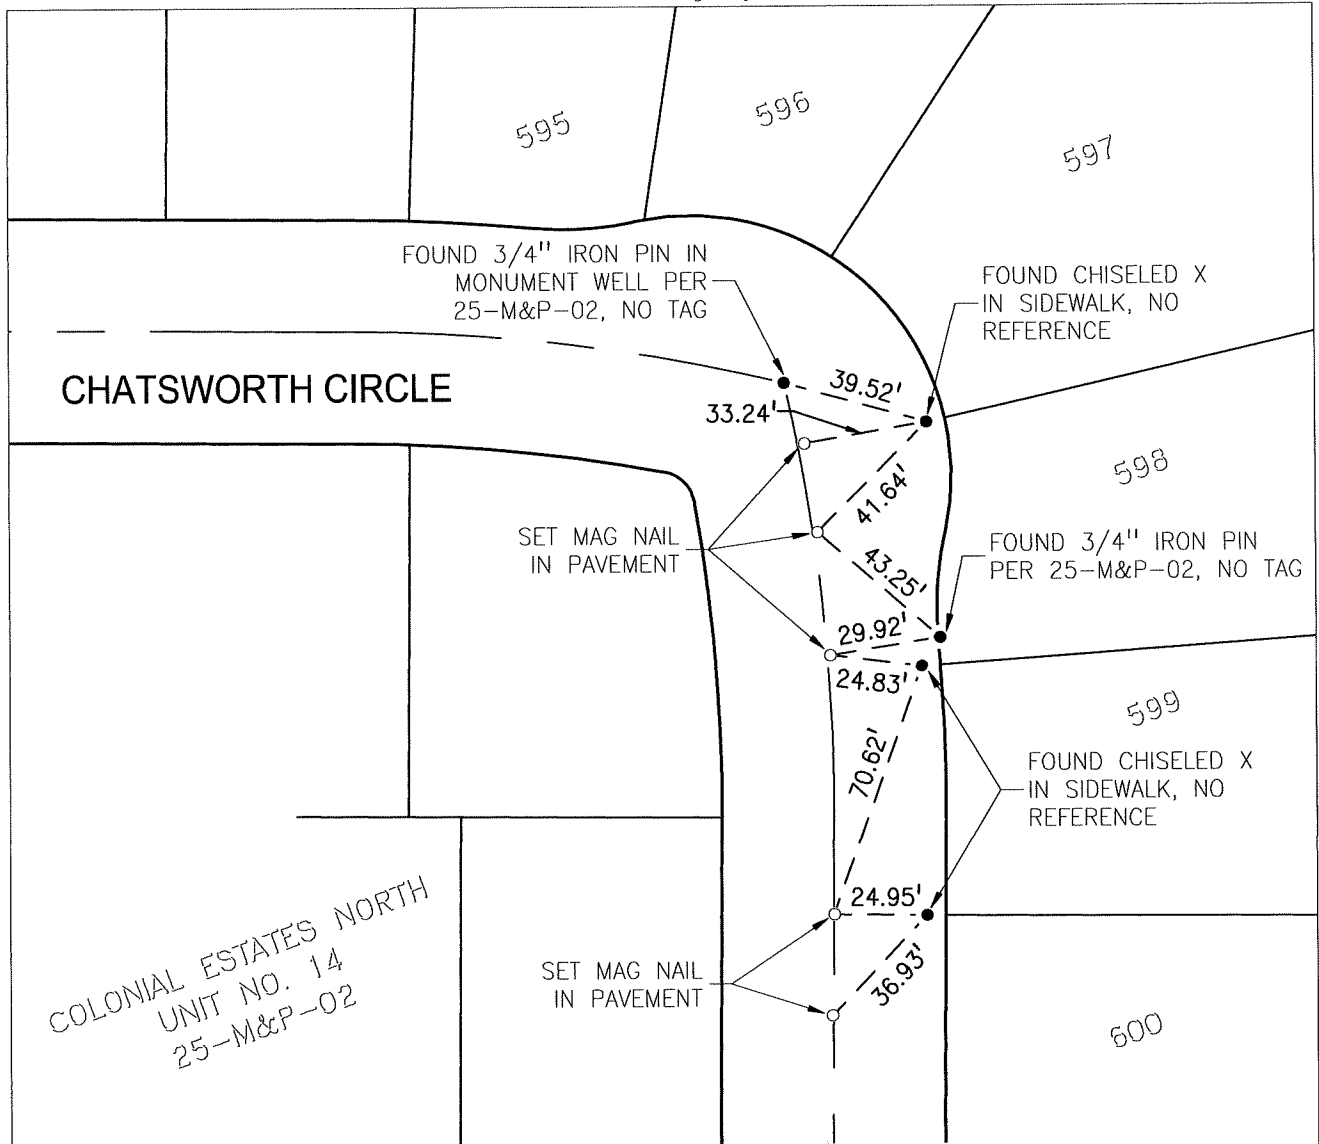

LEGEND:

M&P MAPS AND PLATS
 S.J.C.R. SAN JOAQUIN COUNTY RECORDS

