

CORNER RECORD


Agency Index CR-20-66

Document Number _____

City of RIPON

County of SAN JOAQUIN, California

Brief Legal Description SOUTHWEST CORNER OF PARCEL B PER 6-PM-195, SAN JOAQUIN COUNTY RECORDS

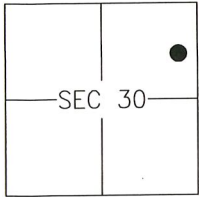

CORNER TYPE

- Government Corner Control
 Meander Property
 Rancho Other

Date of Survey 2019-12-24

COORDINATES (Optional)

N. _____ E. _____

Elevation _____

Units Metric U.S. Survey Foot

Horizontal Datum _____

Zone _____ Epoch Date _____

Vertical Datum: _____

Complies with Public Resources Code §§8801-8819

Complies with Public Resources Code §§8890-8902

PLS Act Ref.: 8765(d) 8771 8773 Other: _____

Corner/Monument: Left as found Established Rebuilt Pre-Construction
 Found and tagged Reestablished Referenced Post-Construction


Narrative of corner identified and monument as found and set or reset:

See sheet #2 for description(s):

SURVEYOR'S STATEMENT

This Corner Record was prepared by me or under my direction in conformance with the Professional Land Surveyor's Act on 31 January, 2020.

Signed [Signature] P.L.S. or R.C.E. No.: 8040

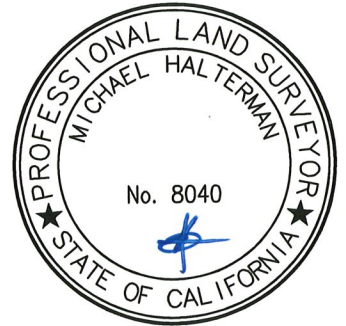

COUNTY SURVEYOR'S STATEMENT

This Corner Record was received March 4, 2020 and examined and filed March 24, 2020.


Signed James E. Hart P.L.S. or R.C.E. No.: 8657
 Title County Surveyor

County Surveyor's Comment _____



LOT 13
15-R.S.-158

PARCEL B
6-P.M.-195

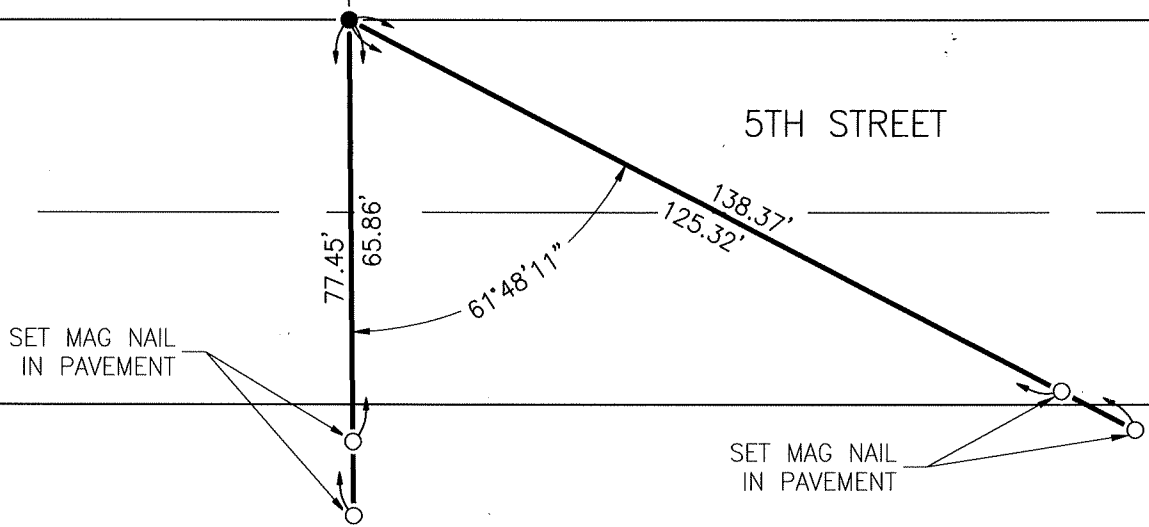

LEGEND

- FOUND 3/4" IRON PIN TAGGED LS 4450 PER BOOK 6 OF PARCEL MAPS, AT PAGE 195, SAN JOAQUIN COUNTY RECORDS
- SET NAIL AS NOTED
- P.M. PARCEL MAP
- R.S. RECORD OF SURVEY

