

# CORNER RECORD

Agency Index CR-20-86

Document Number \_\_\_\_\_


City of STOCKTON

County of SAN JOAQUIN, California

Brief Legal Description MONUMENTS NEAR INTERSECTION OF HICKOCK COURT AND DRIVE PER 22-M&P-82

### CORNER TYPE

### COORDINATES (Optional)

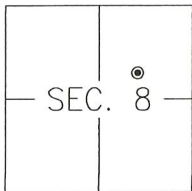

Government Corner  Control   
 Meander  Property   
 Rancho  Other

Date of Survey 2019-01-10

N. \_\_\_\_\_ E. \_\_\_\_\_

Elevation \_\_\_\_\_

Units Metric  U.S. Survey Foot

Horizontal Datum \_\_\_\_\_

Zone \_\_\_\_\_ Epoch Date \_\_\_\_\_

Vertical Datum: \_\_\_\_\_

Complies with Public Resources Code §§8801-8819

Complies with Public Resources Code §§8890-8902

PLS Act Ref.:  8765(d)  8771  8773 Other: \_\_\_\_\_

Corner/Monument:  Left as found  Established  Rebuilt  Pre-Construction  
 Found and tagged  Reestablished  Referenced  Post-Construction

Narrative of corner identified and monument as found, set, reset, replaced, or removed:

See sheet #2 for description(s):

FOUND MONUMENTS AND SET REFERENCE POINTS AS SHOWN ON SHEET #2.

### SURVEYOR'S STATEMENT

This Corner Record was prepared by me or under my direction in conformance with

the Professional Land Surveyor's Act on APRIL 6TH, 2020

Signed [Signature] P.L.S. or R.C.E. No.: 8366



### COUNTY SURVEYOR'S STATEMENT

This Corner Record was received April 13, 2020 and examined

and filed May 14, 2020

Signed James E. Hart P.L.S. or R.C.E. No.: 8657

Title County Surveyor

County Surveyor's Comment \_\_\_\_\_




**LEGEND:**

(A) DATA PER WESTERN VALLEY ESTATES, UNIT NO. 6, BOOK 22 OF MAPS AND PLATS, PAGE 82, SAN JOAQUIN COUNTY RECORDS

SFN SEARCHED, FOUND NOTHING

M&P MAPS AND PLATS

FOUND 3/4" IRON PIN, TAGGED RCE 15831, IN MONUMENT WELL (A)

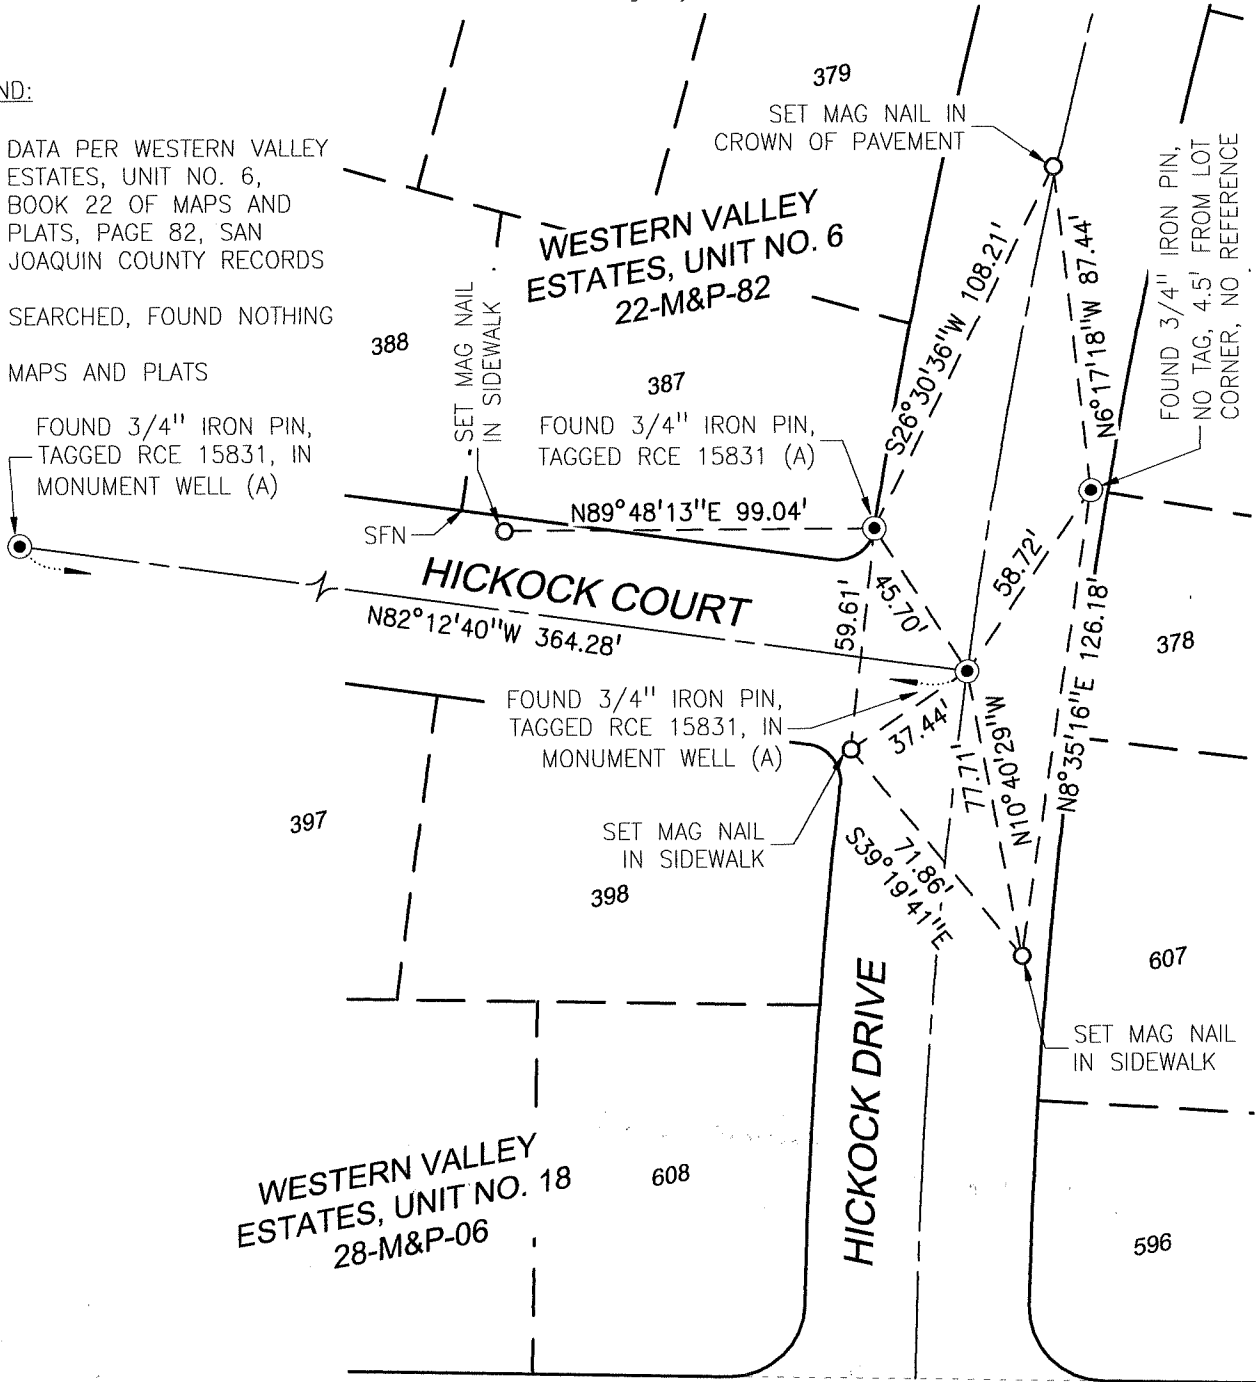

**WAGNER HEIGHTS ROAD**

**NOTES:**

1. THE BEARINGS SHOWN ARE FROM POINT TO POINT AND NOT INTENDED TO REFLECT COURSES SHOWN ON RECORD MAPS.
2. THE FOUND MONUMENTS ARE SHOWN IN THE POSITIONS AS FOUND. NO ATTEMPT WAS MADE TO ESTABLISH THE VALIDITY OF THEIR POSITIONS IN RELATION TO BOUNDARY LINES, RIGHTS-OF-WAY, OR OTHER RECORD POSITIONS.

