
## **CORNER RECORD**

Agency Index \_ CR-26-89 Document Number \_\_ County of SAN JOAQUIN , California City of STOCKTON Brief Legal Description MONUMENTS ALONG THE WEST LINE OF PARCEL 4, PM 22-19 **CORNER TYPE COORDINATES (Optional)** Flevation Control Government Corner Metric U.S. Survey Foot Units Property Meander T2N/R6E Horizontal Datum \_ Rancho Other Zone \_\_\_\_\_ Epoch Date \_ SEC Vertical Datum: \_\_ Date of Survey \_2019-01-23 Complies with Public Resources Code §\$8801-8819 Complies with Public Resources Code §§8890-8902 8773 Other: 8765(d)  $\boxtimes$ 8771 PLS Act Ref .: Left as found Established Rebuilt Pre-Construction Corner/ Post-Construction Monument: Found and tagged Reestablished Referenced Narrative of corner identified and monument as found, set, reset, replaced, or removed: See sheet #2 for description(s): FOUND 3 - 3/4" IRON PIPES, NO TAG, ALONG THE WEST LINE OF PARCEL 4 AS SHOWN ON THE PARCEL MAP FILED IN BOOK 22 OF PARCEL MAPS, PAGE 19, SAN JOAQUIN COUNTY RECORDS, NEAR THE INTERSECTION OF HAMMER LANE AND HOLMAN ROAD. SURVEYOR'S STATEMENT This Corner Record was prepared by me or under my direction in conformance with the Professional Land Surveyor's Act on No. 8366 Signed Exp. 12-31-2019COUNTY SURVEYOR'S STATEMENT This Corner Record was received April 13 2020 and examined County Surveyor's Comment \_\_\_

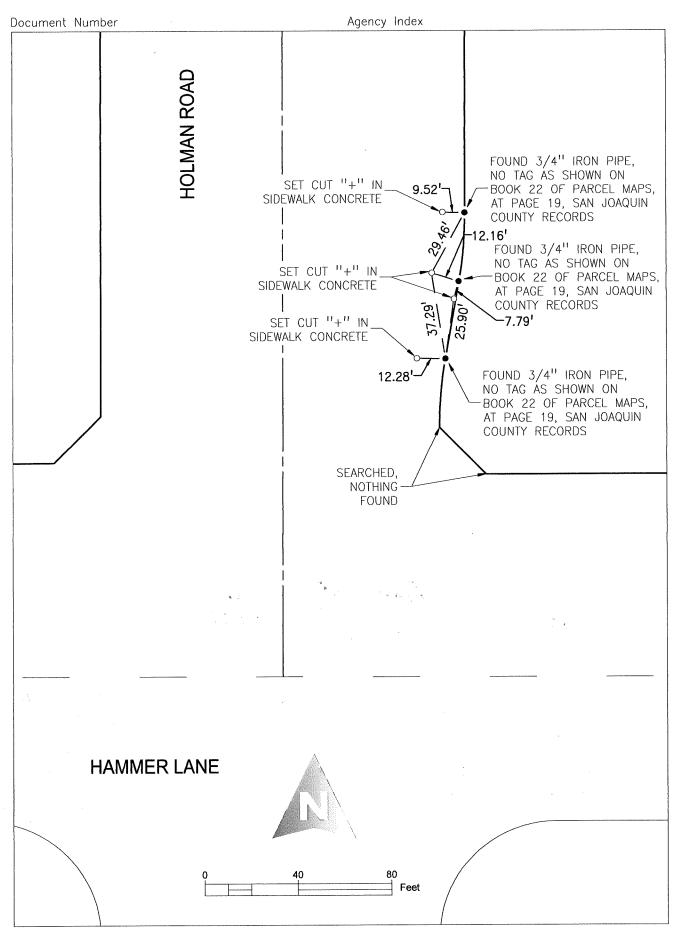

Page 2 of 2