City of	NER REC	County of	Agency Index Document Number San Jos	CR-20-106
				M&P 22-68, 23-38 & 24-27
CORNER TYPE		COORDINATES (Optional) N. E.		
T.3N., R.6E.	Government Country Meander Rancho Date of Survey	Orner Control Property Other May 26, 2020	Vertical Datum Complies with Publ	U.S. Survey Foot
PLS Act Ref.:	8765(d)	× 8771	8773	Other:
Corner/ Monument:	Left as found Found and tagged	Established Reestablished	Rebuilt Referenced	Pre-Construction Post-Construction
Narrative of corner ider ✓ See sheet #2 for de	ntified and monument as four escription(s):	nd, set, reset, replaced, o	or removed:	
monuments note construction. The	rosses at lot line proje d on sheet 2 were use e found chiseled cros ion prior to construction	ed to establish the ses that were remo	location of the chis	
14 15	SURVEYOR'S S	TATEMENT		SENSED LAND SURVEY
This Corner Record wa	s prepared by me or under r	my direction in conformar	nce with	(mm
the Professional Land	Surveyors' Act on	une 15, Ze		No. 7269 ZU X

P.L.S or R.C.E. No.


COUNTY SURVEYOR'S STATEMENT

Signed

This Corner Record was received				
and examined and filed July 2, 2020.				
Signed P.L.S. OFR.G.E. No. 8657				
Title County Surveyor				
County Surveyor's Comment				



BPELSG-2016 Page 1 of 2

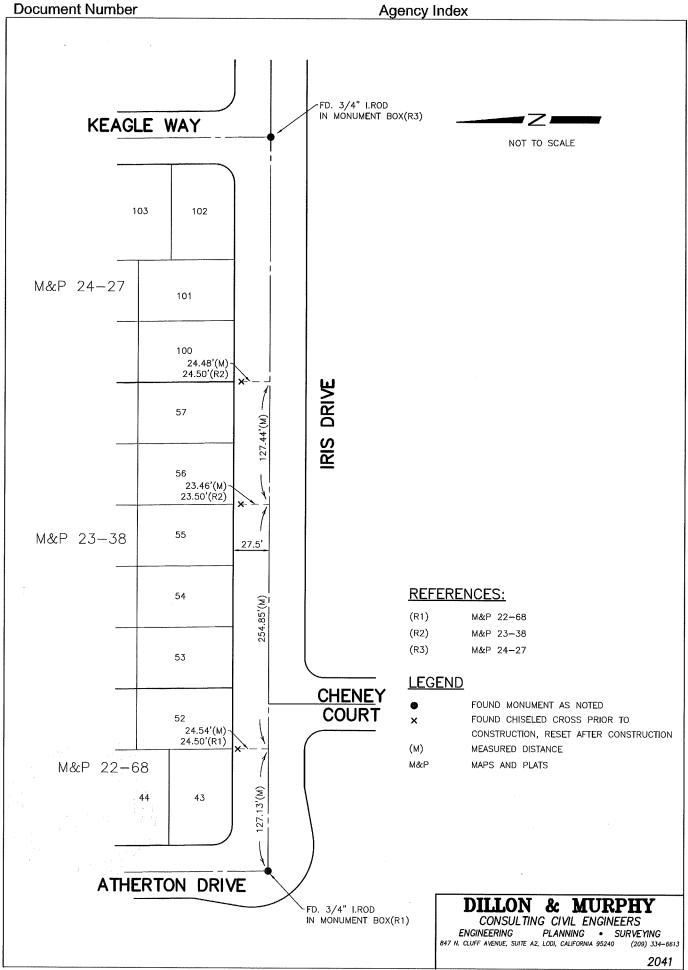

S:\2020\2041\BOUNDARY-CORNER RECORD PLAT.dwg Jun 19, 2020