
CORNER RECORD

Document Number _____ County of SAN JOAQUIN , California City of UNINCORPORATED Brief Legal Description MONUMENT ON WEST SIDE OF CHERRYLAND AVENUE, 12-S-156, S.J.C.R. **CORNER TYPE** COORDINATES (Optional) Government Corner Control Elevation Metric U.S. Survey Foot SEC. Property Meander 53 Horizontal Datum _ Rancho Other X ____ Epoch Date ___ Vertical Datum: ____ C.M. WFBFR Date of Survey MARCH 3, 2020 Complies with Public Resources Code §§8801-8819 GRANT Complies with Public Resources Code §§8890-8902 PLS Act Ref.: 8765(d) \boxtimes 8773 Corner/ Left as found Established Rebuilt Pre-Construction Monument: Found and tagged Reestablished Referenced Post-Construction Narrative of corner identified and monument as found, set, reset, replaced, or removed: See sheet #2 for description(s): SURVEYOR'S STATEMENT This Corner Record was prepared by me or under my direction in conformance with the Professional Land Surveyor's Act or Signed Exp. 12-31-202OF CALIF COUNTY SURVEYOR'S STATEMENT P.L.S. or R.C.E. No.: **8657** Title County Surveyor's Comment _

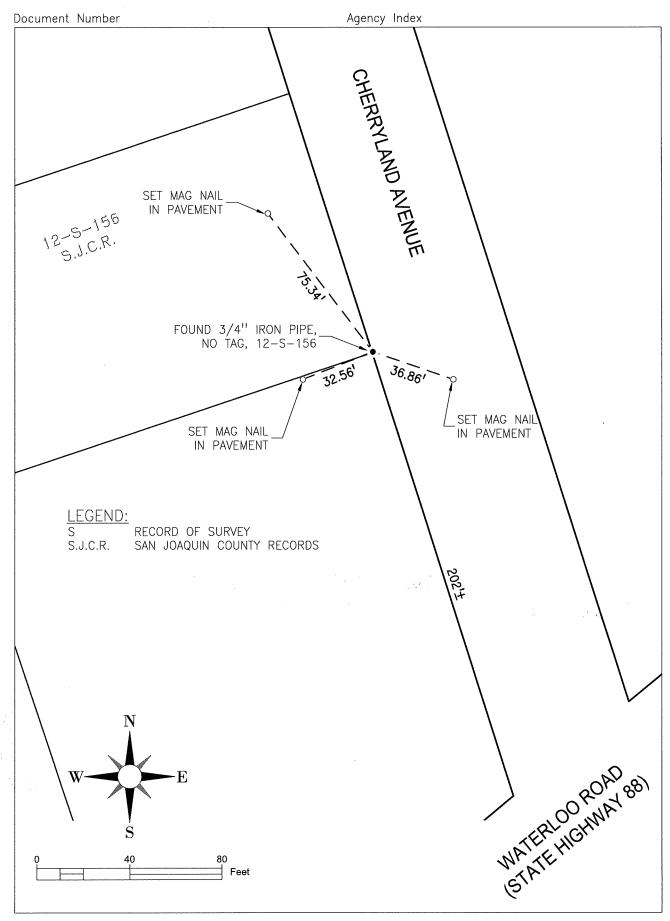

Page 2 of 2