

CORNER RECORD


Agency Index CR-20-120

Document Number _____

City of UNINCORPORATED

County of SAN JOAQUIN, California

Brief Legal Description MOST SOUTHERLY CORNER OF PARCEL 1, 26-PM-10, S.J.C.R.

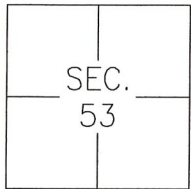

C.M. WEBER
GRANT

CORNER TYPE

- Government Corner Control
 Meander Property
 Rancho Other

Date of Survey MARCH 3, 2020

COORDINATES (Optional)

- N. _____ E. _____
 Elevation _____
 Units Metric U.S. Survey Foot
 Horizontal Datum _____
 Zone _____ Epoch Date _____
 Vertical Datum: _____
 Complies with Public Resources Code §§8801-8819
 Complies with Public Resources Code §§8890-8902

PLS Act Ref.: 8765(d) 8771 8773 Other: _____

Corner/Monument: Left as found Established Rebuilt Pre-Construction
 Found and tagged Reestablished Referenced Post-Construction

Narrative of corner identified and monument as found, set, reset, replaced, or removed:

See sheet #2 for description(s):

SURVEYOR'S STATEMENT

This Corner Record was prepared by me or under my direction in conformance with

the Professional Land Surveyor's Act on JUNE 26TH, 2020

Signed [Signature] P.L.S. or R.C.E. No.: 8366



COUNTY SURVEYOR'S STATEMENT

This Corner Record was received June 26, 2020 and examined

and filed July 9, 2020

Signed James E. Hart P.L.S. or R.C.E. No.: 8657

Title County Surveyor

County Surveyor's Comment _____




LEGEND:

PM PARCEL MAP
S.J.C.R. SAN JOAQUIN COUNTY RECORDS

PARCEL 1
26-PM-10
S.J.C.R.

DESIGNATED
REMAINDER
26-PM-10
S.J.C.R.

FOUND 5/8" REBAR TAGGED
PLS 8247 PER 26-PM-10

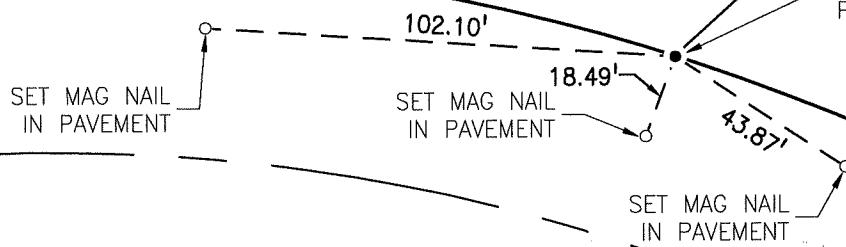

WILCOX ROAD

