

CORNER RECORD

Agency Index

CR-20-148

Document Number

City of STOCKTON

County of SAN JOAQUIN, California

Brief Legal Description VENETIAN BRIDGES, UNIT NO. 1, VOLUME 23 OF MAPS & PLATS, PAGE 50.



CORNER TYPE

Government Corner ☐ Control
Meander ☐ Property
Rancho ☐ Other

COORDINATES (Optional)

N. _____ E. _____
☐ Elevation
☒ Units Metric ☐ U.S. Survey Foot ☒
☐ Horizontal Datum NAD83
Zone III Epoch Date 1991.35
Vertical Datum NAVD88

T. 2N., R. 6E., M.D.B.&M. Date of Survey MARCH 24, 2020

☐ Complies with Public Resources Code §§8801-8819
☐ Complies with Public Resources Code §§8890-8902

PLS Act Ref: ☐ 8765(d)

☒ 8771

☐ 8773

☐ Other:

Corner/
Monument:

☒ Left as found

☐ Established

☐ Rebuilt

☒ Pre-Construction

☐ Found and tagged

☐ Reestablished

☐ Referenced

☐ Post-Construction

Narrative of corner identified and monument as found, set, reset, replaced, or removed:

☒ See sheet #2 for description (s):

SURVEYOR'S STATEMENT

This Corner Record was prepared by me or under my direction in conformance with the Professional Land Surveyors' Act on 08/06/2020

Signed Randell Scott West P.L.S. or R.C.E. No. 8663



COUNTY SURVEYOR'S STATEMENT

This Corner Record was received August 11, 2020

and examined and filed August 27, 2020

Signed James E. Hart P.L.S. or R.C.E. No. 8657

Title County Surveyor



County Surveyor's Comment _____

STATEMENT OF PURPOSE:

THE PURPOSE OF THIS SURVEY IS TO IDENTIFY AND RECORD THE LOCATION OF EXISTING MONUMENTS PRIOR TO THE CONSTRUCTION OF PG&E FACILITIES AROUND THE MONUMENTS. THE PURPOSE OF THIS SURVEY IS NOT TO MAKE PROPERTY LINE DETERMINATIONS. LOT LINES SHOWN HEREON ARE FOR GENERAL LOCATION AND INFORMATIONAL PURPOSES ONLY.


DATUM STATEMENT:

COORDINATES SHOWN HEREON ARE GRID AND ARE BASED ON CITY OF STOCKTON MONUMENTS 7N-14 AND 7N-16, CALIFORNIA COORDINATE SYSTEM (CCS83), ZONE III, 1983 NAD, (1991.35 EPOCH ADJUSTMENT OF THE HIGH PRECISION GEODETIC NETWORK) AS SHOWN ON RECORD OF SURVEY BOOK 33 OF SURVEYS, PAGE 20. THE PROJECT SPECIFIC COMBINED SCALE FACTOR IS 0.99994060.

LEGEND:



INDICATES FOUND 3/4" IRON PIN IN MONUMENT WELL, NO TAG, PER TRACT NO. 1323, AS SHOWN IN BOOK OF MAPS AND PLATS, VOLUME 23, PAGE 50, RECORDS OF SAN JOAQUIN COUNTY

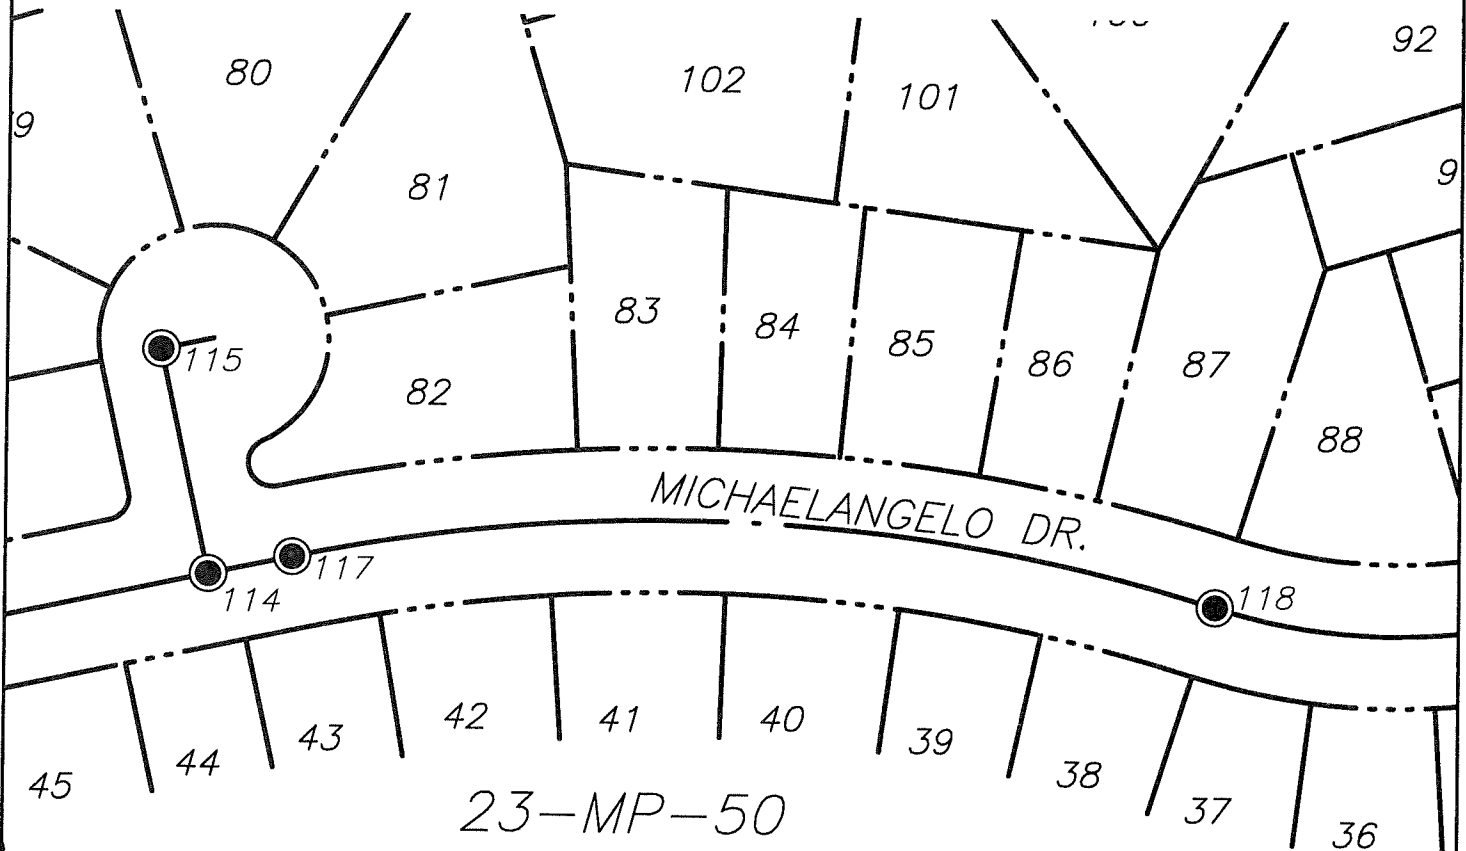

GRID COORDINATES (U.S. SURVEY FEET)		
POINT	NORTHING	EASTING
114	2180702.62'	6319895.50'
115	2180795.96'	6319875.13'
117	2180710.09'	6319929.69'
118	2180693.21'	6320310.74'

