


CORNER RECORD

Agency Index CR-20-163
Document Number _____

City of LODI County of SAN JOAQUIN, California
Brief Legal Description NW CORNER OF E 1/2 OF E 1/2 OF SE 1/4 OF SE 1/4, SECTION 7, T.3N., R.7E., M.D.B.&M.

CORNER TYPE

COORDINATES (Optional)

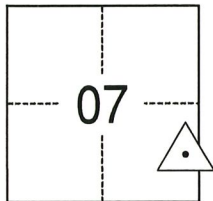

- Government Corner
- Meander
- Rancho
- Control
- Property
- Other

Date of Survey 08-21-2019

N. _____ E. _____
 Elevation _____
 Units Metric U.S. Survey Foot
 Horizontal Datum _____
 Zone _____ Epoch Date _____
 Vertical Datum _____
 Complies with Public Resources Code §§8801-8819
 Complies with Public Resources Code §§8890-8902

T.03N., R.07E., M.D.B.&M.

- PLS Act Ref.: 8765(d) 8771 8773 Other:
- Corner/Monument: Left as found Established Rebuilt Pre-Construction
 Found and tagged Reestablished Referenced Post-Construction

Narrative of corner identified and monument as found, set, reset, replaced, or removed:

See sheet #2 for description(s):

FOUND 5/8" REBAR, NO TAG, DOWN 0.5' (NO RECORD) NEAR THE NORTHWEST CORNER OF THE EAST 1/2 OF THE EAST 1/2 OF THE SOUTHEAST 1/4 OF THE SOUTHEAST 1/4 OF SECTION 7, TOWNSHIP 3 NORTH, RANGE 7 EAST, M.D.B.&M.

LEFT AS FOUND. ESTABLISHED NEW TIES, SEE REVERSE FOR DETAILS.

SURVEYOR'S STATEMENT

This Corner Record was prepared by me or under my direction in conformance with

the Professional Land Surveyors' Act on 8.20.20

Signed Dylan Crawford (P.L.S.) or R.C.E. No. 7788



COUNTY SURVEYOR'S STATEMENT

This Corner Record was received August 26, 2020

and examined and filed September 15, 2020

Signed James E. Hart P.L.S. or R.C.E. No. 8657


Title County Surveyor

County Surveyor's Comment



LEGEND

- MONUMENT TIE LINE -----
- PROPERTY LINE _____
- PM PARCEL MAP, SAN JOAQUIN COUNTY RECORDS
- D.N. DOCUMENT NUMBER, SAN JOAQUIN COUNTY RECORDS
- I.N. INSTRUMENT NUMBER, SAN JOAQUIN COUNTY RECORDS

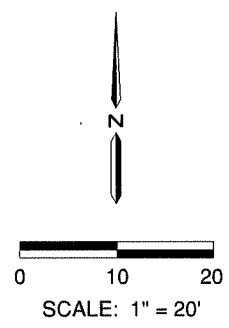

20-PM-128
(DESIGNATED REMAINDER)

CERTIFICATE OF COMPLIANCE 2018-34CC
 (D.N. 2019-007887)

