


CORNER RECORD

Agency Index CR-20-183
Document Number _____
County of SAN JOAQUIN, California

City of STOCKTON

Brief Legal Description LOTS 244 AND 245 NORMANDY PROVENCE UNIT NO. 7 FILED IN BOOK 23 OF MAPS AND PLATS, PAGE 91, IN N.E. 1/4 OF SECTION 14, T. 2 N., R. 6 E., M.D.M.

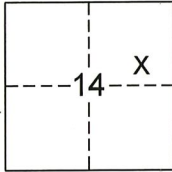

T. 2 N., R. 6 E.

CORNER TYPE:

Government Corner Control
Meander Property
Rancho Other

Date of Survey JULY 29, 2020

COORDINATES (Optional)

N. _____ E. _____

Elev. _____

Units Metric U.S. Survey Foot

Horizontal Datum _____

Zone _____ Epoch Date _____

Vert. Datum: _____

Complies with Public Resources Code § 8801-8819

Complies with Public Resources Code § 8890-8902

PLS Act Ref.: 8765(d) 8771 8773 Other:

Corner/Monument Left as found Established Rebuilt Pre-Construction
 Found and tagged Reestablished Referenced Post-Construction

Narrative of corner identified and monument as found, set, reset, replaced, or removed:

See sheet # 2 for description(s):

FOUND 3/4" IRON ROD NO TAG (22-M&P-99) AND (23-M&P-91). MONUMENT IS IN VICINITY OF WALL CONSTRUCTION. SET REFERENCE TIES AS SHOWN ON SHEET 2.

SURVEYOR'S STATEMENT

This Corner Record was prepared by me or under my direction in conformance with the Land Surveyor's Act on October 5, 2020
Signed [Signature] P.L.S. or R.C.E. No. 7823




COUNTY SURVEYOR'S STATEMENT

This Corner Record was received October 8, 2020
and examined and filed October 22, 2020
Signed [Signature] P.L.S. or R.C.E. No. 8657
Title County Surveyor



County Surveyor's Comment:

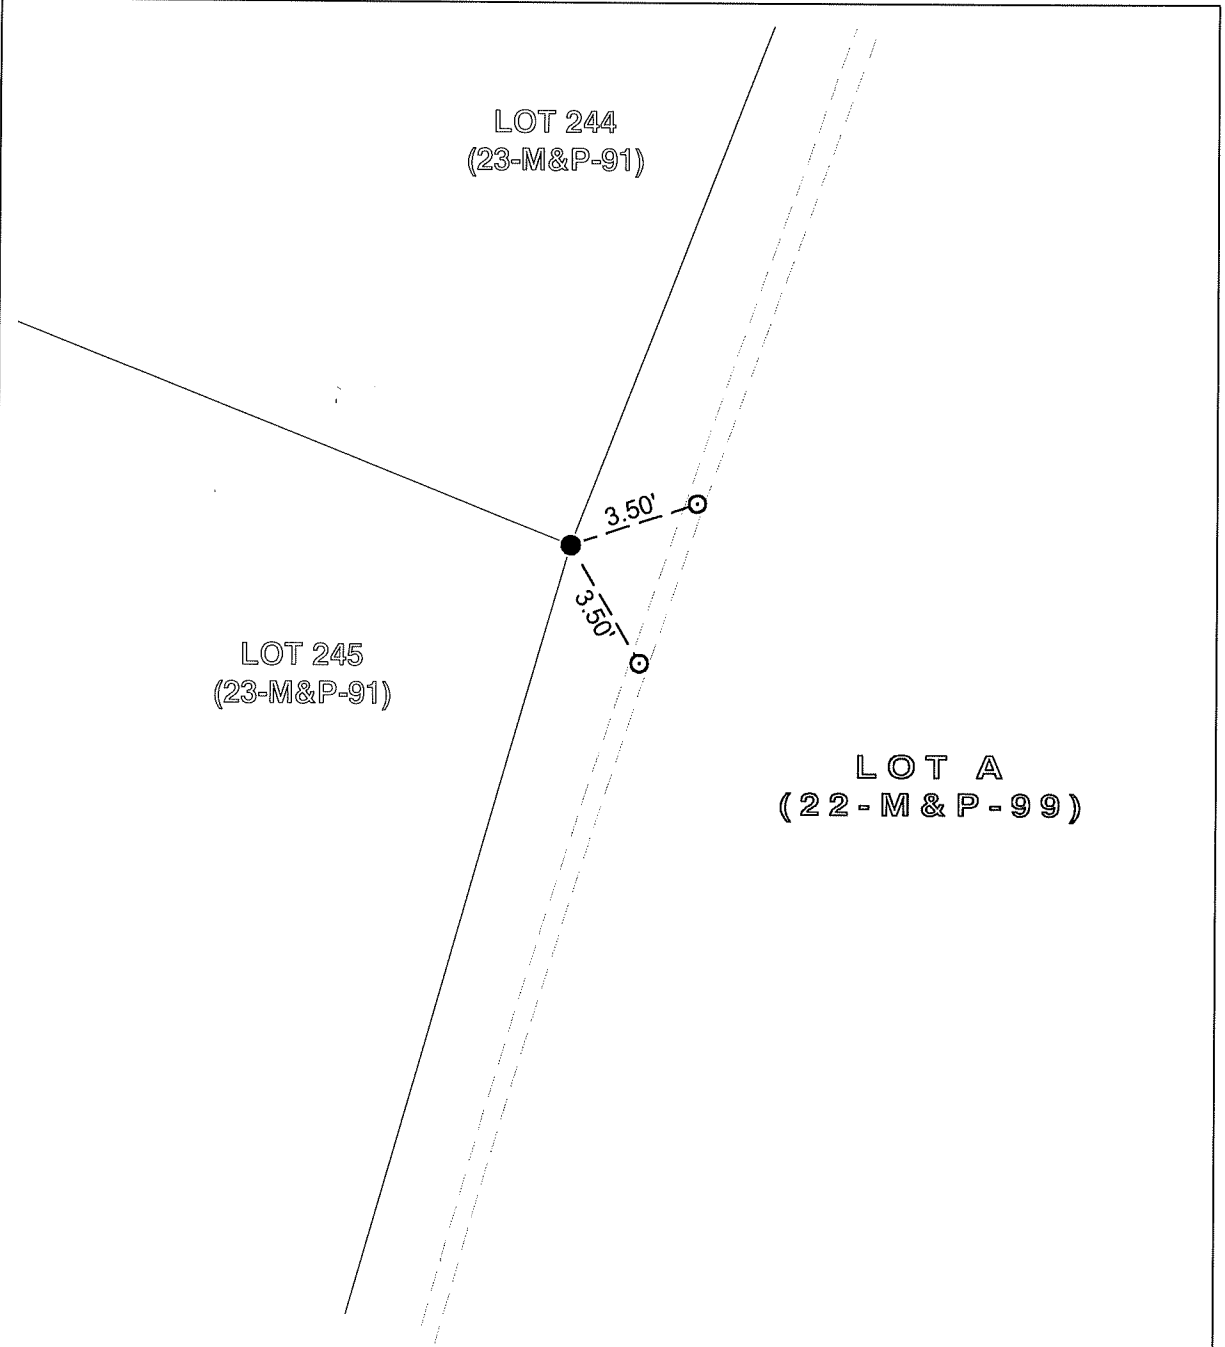

LEGEND

- FOUND 3/4" IRON ROD NO TAG (22 - M & P - 99) (23 - M & P - 91)
 - ⊙ SET NAIL AND BRASS TAG STAMPED L.S. 7823 IN CURB AS 3.50' WITNESS CORNER TO FOUND IRON ROD
 - ⊕ SET CHISELED "X" IN CONCRETE
- ALL REFERENCES ARE SAN JOAQUIN COUNTY RECORDS



SCALE 1" = 5'