
## **CORNER RECORD**

Agency Index \_\_\_\_\_\_CR-10-110 Document Number \_\_\_\_\_ County of SAN JOAQUIN , California City of STOCKTON Brief Legal Description BRASS PLUG AT NORTHWEST CORNER OF STANISLAUS STREET AND CHANNEL STREET **CORNER TYPE** COORDINATES (Optional) Government Corner Control Metric U.S. Survey Foot Meander **Property** Horizontal Datum \_ Rancho Other Zone \_\_\_\_\_ Epoch Date \_\_\_ Vertical Datum: \_ Date of Survey MARCH 13. 2020 C.M. WEBER Complies with Public Resources Code §§8801-8819 **GRANT** Complies with Public Resources Code §§8890-8902 8773 PLS Act Ref.: 8765(d) 8771 Pre-Construction Left as found Established Rebuilt Corner/ Reestablished Referenced Post-Construction Found and tagged Monument: Narrative of corner identified and monument as found, set, reset, replaced, or removed: See sheet #2 for description(s): SURVEYOR'S STATEMENT This Corner Record was prepared by me or under my direction in conformance with the Professional Land Surveyor's Act on No. 8366 Signed \_ Exp. 12-31-202 OF CALIF **COUNTY SURVEYOR'S STATEMENT** This Corner Record was received November 4, 2020 and examined and filed November 24, 2020. James E. Hart P.L.S. or R.G.E. No.: 8657 County Surveyor County Surveyor's Comment \_\_\_\_\_

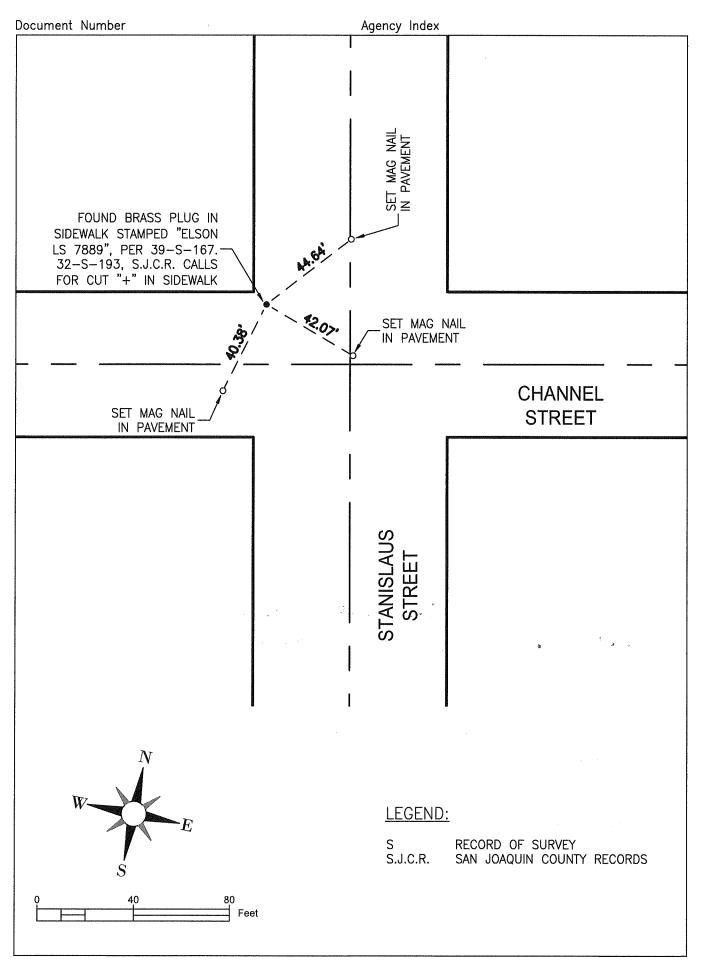

Page 2 of 2