**CORNER RECORD** Document Number \_\_\_ City of STOCKTON County of SAN JOAQUIN , California Brief Legal Description CUT "+" ON SOUTH SIDE OF MINER AVENUE, 192'± EAST OF AMERICAN STREET. **CORNER TYPE** COORDINATES (Optional) Elevation Government Corner Control Metric U.S. Survey Foot Units Meander Property Horizontal Datum Other Rancho \_\_ Epoch Date \_\_\_\_\_ Vertical Datum: C.M. WEBER Date of Survey MARCH 13, 2020 Complies with Public Resources Code §\$8801-8819 **GRANT** Complies with Public Resources Code \$\$8890-8902 PLS Act Ref.: 8773 8765(d) X **Established** Rebuilt Pre-Construction Corner/ Left as found Monument: Found and tagged Reestablished Referenced Post-Construction Narrative of corner identified and monument as found, set, reset, replaced, or removed: See sheet #2 for description(s):


## SURVEYOR'S STATEMENT

This Corner Record was prepared by me or under my direction in conformance with the Professional Land Surveyor's Act on \_ Signed COUNTY SURVEYOR'S STATEMENT



This Corner Record was received November 4 , 2020 and examined and filed November 24. 2020 P.L.S. <del>of R.C.</del>E. No.: <u>8657</u>

County Surveyor's Comment \_\_\_\_\_

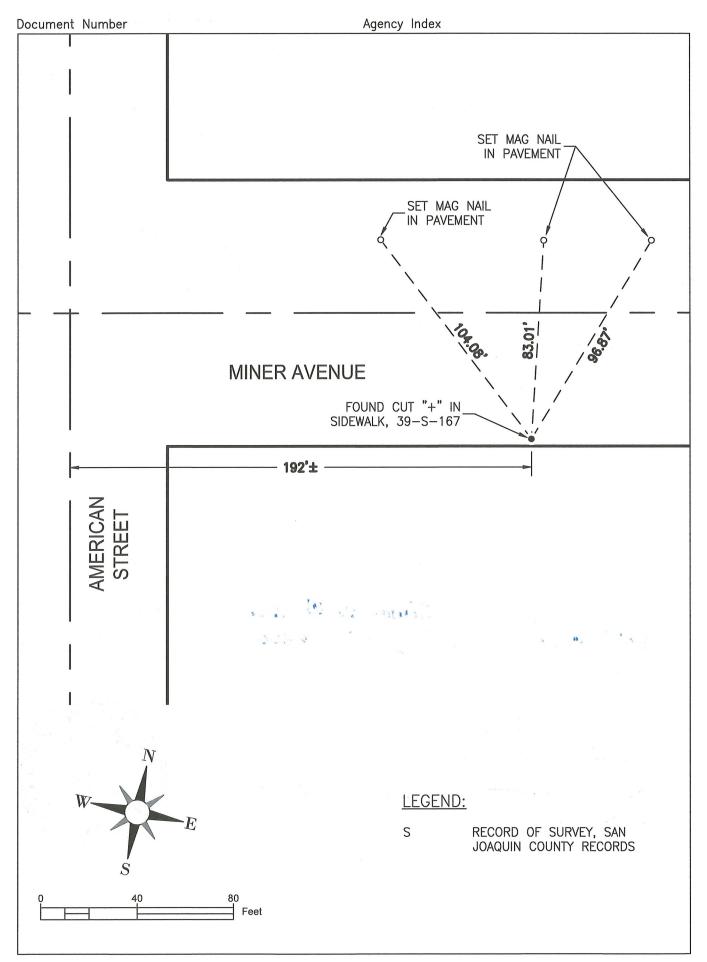

Page 2 of 2