


CORNER RECORD

Agency Index: CR-20-222

Document Number: _____

City of _____ County of SAN JOAQUIN, California

Brief Legal Description MONUMENTS ±1120' & ±1320' SOUTH OF THE INTERSECTION OF COMSTOCK ROAD ON WALL ROAD.

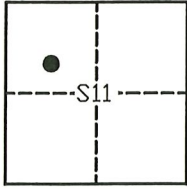

T.2N, R.8E

CORNER TYPE

- Government Corner Control
 Meander Property
 Rancho Other

Date of Survey 09-11-2020

COORDINATES (Optional)

N. _____ E. _____

Elevation _____

Units Metric U.S. Survey Foot

Horizontal Datum _____

Zone _____ Epoch Date _____

Vertical Datum _____

Complies with Public Resources Code SS8801-8819

Complies with Public Resources Code SS8890-8902

PLS Act Ref: 8765(d) 8771 8773 Other:

Corner/
 Monument: Left as found Established Rebuilt Pre-Construction
 Found and Tagged Reestablished Referenced Post-Construction

Narrative of corner identified and monument as found, set, reset, replaced, or removed:

See sheet #2 for description(s):

FOUND TWO (2) 3/4" IRON PIPES NOT TAGGED AND TWO (2) MAG NAILS WITH WASHERS ±1120' & ±1320' SOUTH OF COMSTOCK ROAD ON WALL ROAD. SET THREE (3) 3/4" IRON PIPES WITH CAPS "L.S.6953" AS WITNESS CORNERS, AS SHOWN ON PAGE 2.

SURVEYOR'S STATEMENT

This Corner Record was prepared by me or under my direction in conformance with the Land Surveyors' Act on SEPTEMBER 18, 2020,

Signed [Signature] P.L.S. or R.C.E. Number 6953



COUNTY SURVEYOR'S STATEMENT

This Corner Record was received November 24, 2020


and examined and filed December 3, 2020

Signed James E. Hart P.L.S. or R.C.E. No: 8657

Title County Surveyor



County Surveyor's Comment _____

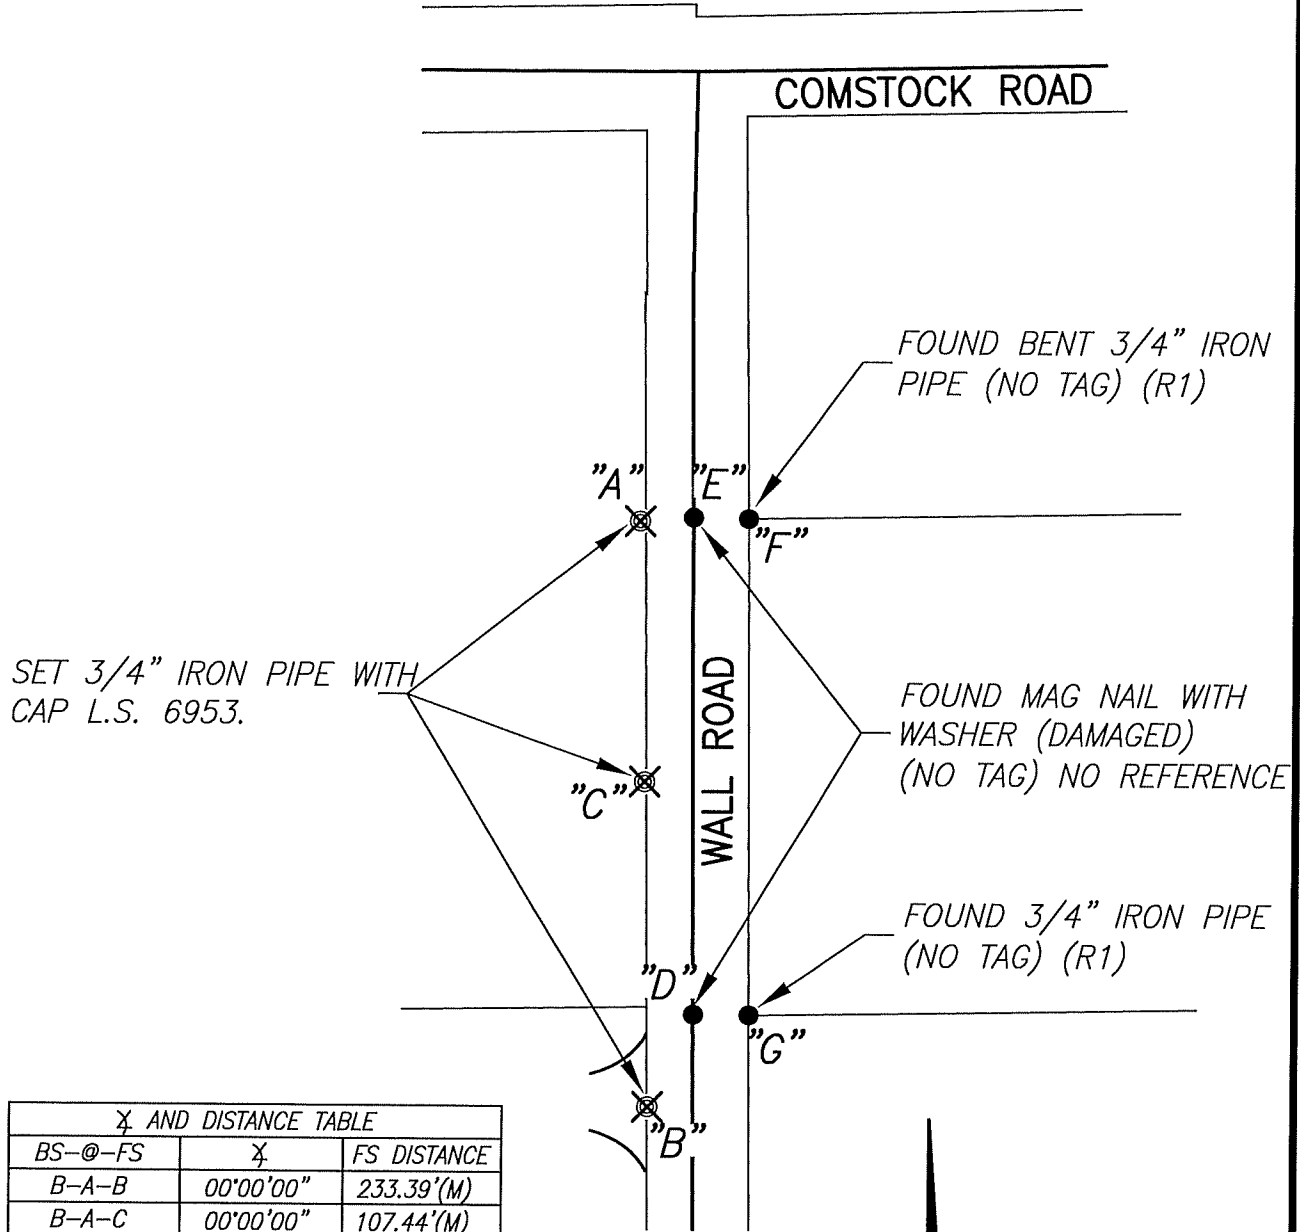

☒ AND DISTANCE TABLE

BS-@-FS	☒	FS DISTANCE
B-A-B	00°00'00"	233.39'(M)
B-A-C	00°00'00"	107.44'(M)
B-A-D	354°08'46"	200.77'(M)
B-A-E	269°06'43"	21.17'(M)
B-A-F	269°18'40"	50.96'(M)
B-A-G	345°48'41"	205.84'(M)

LEGEND:

- ☒ SET MONUMENT AS NOTED.
- FOUND MONUMENT AS NOTED.
- S- DENOTES RECORD OF SURVEY, BOOK & PAGE, S.J.C.R.
- S.J.C.R. DENOTES SAN JOAQUIN COUNTY RECORDS
- (M) MEASURED DISTANCE. ALL DISTANCES ARE MEASURED UNLESS NOTED OTHERWISE.



NOT TO SCALE

REFERENCE:

(R1) 12-S-62, S.J.C.R.