CORNER RECORD Agency Index **Document Number** City of STOCKTON County of SAN JOAQUIN LOT 34, TRACT NO. 13, VICTORY PARK VILLAS, 11 MAPS & PLATS 21 Brief Legal Description **CORNER TYPE COORDINATES (Optional)** Government Corner Control Elevation Meander Units U.S. Survey Foot Property Metric Rancho Other Horizontal Datum **Epoch Date** Zone . Date of Survey OCTOBER 21, 2020 Vertical Datum Complies with Public Resources Code §§8801-8819 Complies with Public Resources Code §§88900-8902 PLS Act Ref.: **⊠** 8765(d) 8771 8773 Other: Left as found **Established** Rebuilt Pre-Construction Corner/ Monument: Found and tagged Reestablished Referenced Post-Construction Narrative of corner identified and monument as found, set, reset, replaced, or removed: See sheet #2 for description(s): FOUND MONUMENTS AT RECORD POSITIONS PER 11 MAPS & PLATS 21 🗽 SET BRASS TAG AND TACK "LS 7539" IN CONCRETE SIDEWALK AT 1.50' OFFSET TO CORNER SEE PAGE #2 FOR OTHER SET AND FOUND MONUMENT DESCRIPTIONS LAND SUA **SURVEYOR'S STATEMENT** JACK M. SMITH This Corner Record was prepared by me or under my direction in conformance with No. 7539 December 10, 2020 the Professional Land Surveyor's Act on Signed P.L.S. or R.C.E. No.

COUNTY SURVEYOR'S STATEMENT

This Corner Record was received

December 14, 2020

and examined and filed

December 29, 2020

Signed


P.L.S. or R.C.E. No. 8657

Title

County Surveyor

County Surveyor



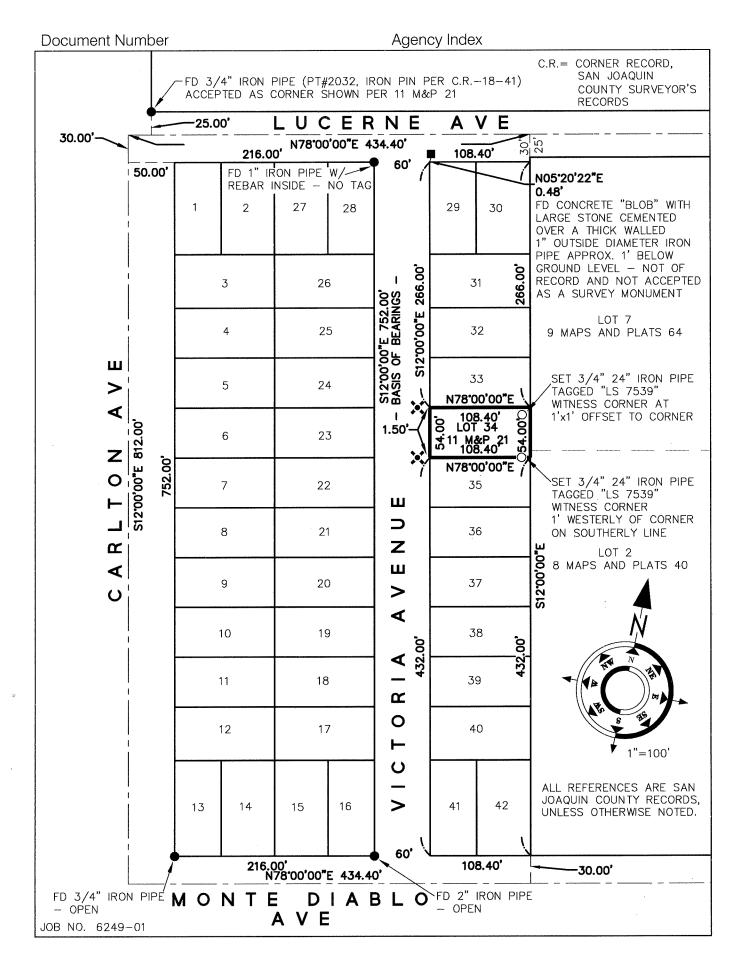

Page 2 of 2