


CORNER RECORD

Agency Index: CR-21-015
Document Number: _____

City of LATHROP County of SAN JOAQUIN, California

Brief Legal Description MONUMENTS AT THE INTERSECTION OF LOUISE AVENUE AND WARFIELD ROAD IN MONUMENT WELLS DUE EAST OF SECTION CORNER.

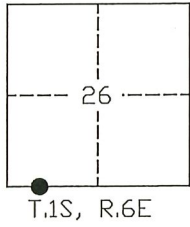

- CORNER TYPE**
- Government Corner Control
 Meander Property
 Rancho Other

Date of Survey 10-20-2020

COORDINATES (Optional)

N. _____ E. _____
Elevation _____
Units Metric U.S. Survey Foot
Horizontal Datum _____
Zone _____ Epoch Date _____
Vertical Datum _____
 Complies with Public Resources Code SS8801-8819
 Complies with Public Resources Code SS8890-8902

- PLS Act Ref: 8765(d) 8771 8773 Other:
- Corner/
Monument: Left as found Established Rebuilt Pre-Construction
 Found and Tagged Reestablished Referenced Post-Construction

Narrative of corner identified and monument as found, set, reset, replaced, or removed:
 See sheet #2 for description(s):
FOUND ONE (1) 3/4" IRON PIPE, TAGGED "L.S. 5122", IN A MONUMENT WELL AT THE INTERSECTION OF LOUISE AVENUE AND WARFIELD ROAD AS SHOWN ON THE RECORD OF SURVEY FILED FOR RECORD IN BOOK 36 OF SURVEYS AT PAGE 147, S.J.C.R.; AND ONE (1) 3/4" REBAR, NO TAG, IN A MONUMENT WELL 30' NORTH OF THE INTERSECTION OF LOUISE AVENUE AND WARFIELD ROAD AS SHOWN ON THE SUBDIVISION MAP FILED FOR RECORD IN BOOK 20 OF MAPS AND PLATS AT PAGE 54, S.J.C.R. SET THREE (3) CONCRETE NAILS WITH BRASS TAGS, MARKED "L.S. 6953", AS WITNESS CORNERS. ALL AS SHOWN ON PAGE 2.

SURVEYOR'S STATEMENT

This Corner Record was prepared by me or under my direction in conformance with the Land Surveyors' Act on OCTOBER 30, 2020

Signed [Signature] P.L.S. or R.C.E. Number 6953



COUNTY SURVEYOR'S STATEMENT

This Corner Record was received December 23, 2020

and examined and filed January 7, 2021

Signed [Signature] P.L.S. or R.C.E. No: 8657

Title County Surveyor



County Surveyor's Comment _____


REFERENCES:

- (R1) 20-M-54, S.J.C.R.
- (R2) 36-S-147, S.J.C.R.

LEGEND:

- ⊗ SET CONCRETE NAILS W/ BRASS TAGS MARKED "L.S. 6953"
- FOUND MONUMENT AS NOTED
- S.J.C.R. DENOTES SAN JOAQUIN COUNTY RECORDS
- S- DENOTES RECORD OF SURVEY
- M- DENOTES MAPS & PLATS
- (M) MEASURED DISTANCE. ALL DISTANCES ARE MEASURED UNLESS OTHERWISE NOTED

X AND DISTANCE TABLE		
BS-@-FS	X	FS DISTANCE
B-A-B	00°00'00"	287.66'(M)
B-A-C	03°16'40"	29.92'(M)
B-A-D	00°00'00"	192.17'(M)
B-A-E	00°00'00"	97.18'(M)

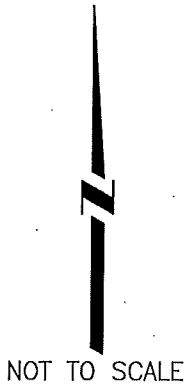

WARFIELD ROAD

"B" ⊗

"D" ⊗

"E" ⊗

"C" ●

"A" ●

LOUISE AVENUE

FOUND 3/4" IRON PIN IN MONUMENT WELL(R1), NO TAG

FOUND 3/4" IRON PIPE, TAGGED "L.S. 5122", IN MONUMENT WELL(R2)

SECTION LINE