

CORNER RECORD

Agency Index CR-21-034


Document Number _____

City of Lodi County of San Joaquin, California

Brief Legal Description Property monuments at Church Street & Locust Street, Section 1, T3N, R6E

CORNER TYPE

COORDINATES (Optional)

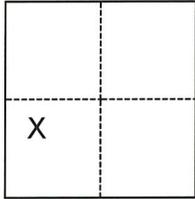

- Government Corner
- Meander
- Rancho
- Control
- Property
- Other

N. _____ E. _____

Elevation _____

Units Metric U.S. Survey Foot

Horizontal Datum _____

Zone _____ Epoch Date _____

Vertical Datum _____

Complies with Public Resources Code §§8801-8819

Complies with Public Resources Code §§8890-8902

Date of Survey January 7, 2021

Section 1, T.3N., R.6E. M.D.B. & M.

PLS Act Ref.: 8765(d) 8771 8773 Other:

Corner/Monument: Left as found Established Rebuilt Pre-Construction

Found and tagged Reestablished Referenced Post-Construction

Narrative of corner identified and monument as found, set, reset, replaced, or removed:

See sheet #2 for description(s):

FOUND 5/8" IRON ROD PER RS 34-154 AT CHURCH STREET & ALLEY SOUTH OF LOCUST STREET. FOUND CHISELED CROSS AT CHURCH STREET & LOCUST STREET (NO RECORD). NO BOUNDARY ANALYSIS WAS PERFORMED.

SURVEYOR'S STATEMENT

This Corner Record was prepared by me or under my direction in conformance with the Professional Land Surveyors' Act on March 31, 2021.

Signed [Signature] P.L.S. or R.C.E. No. 9478



COUNTY SURVEYOR'S STATEMENT

This Corner Record was received April 13, 2021


and examined and filed April 29, 2021.

Signed James E. Hart P.L.S. or R.C.E. No. 8657

Title County Surveyor

County Surveyor's Comment



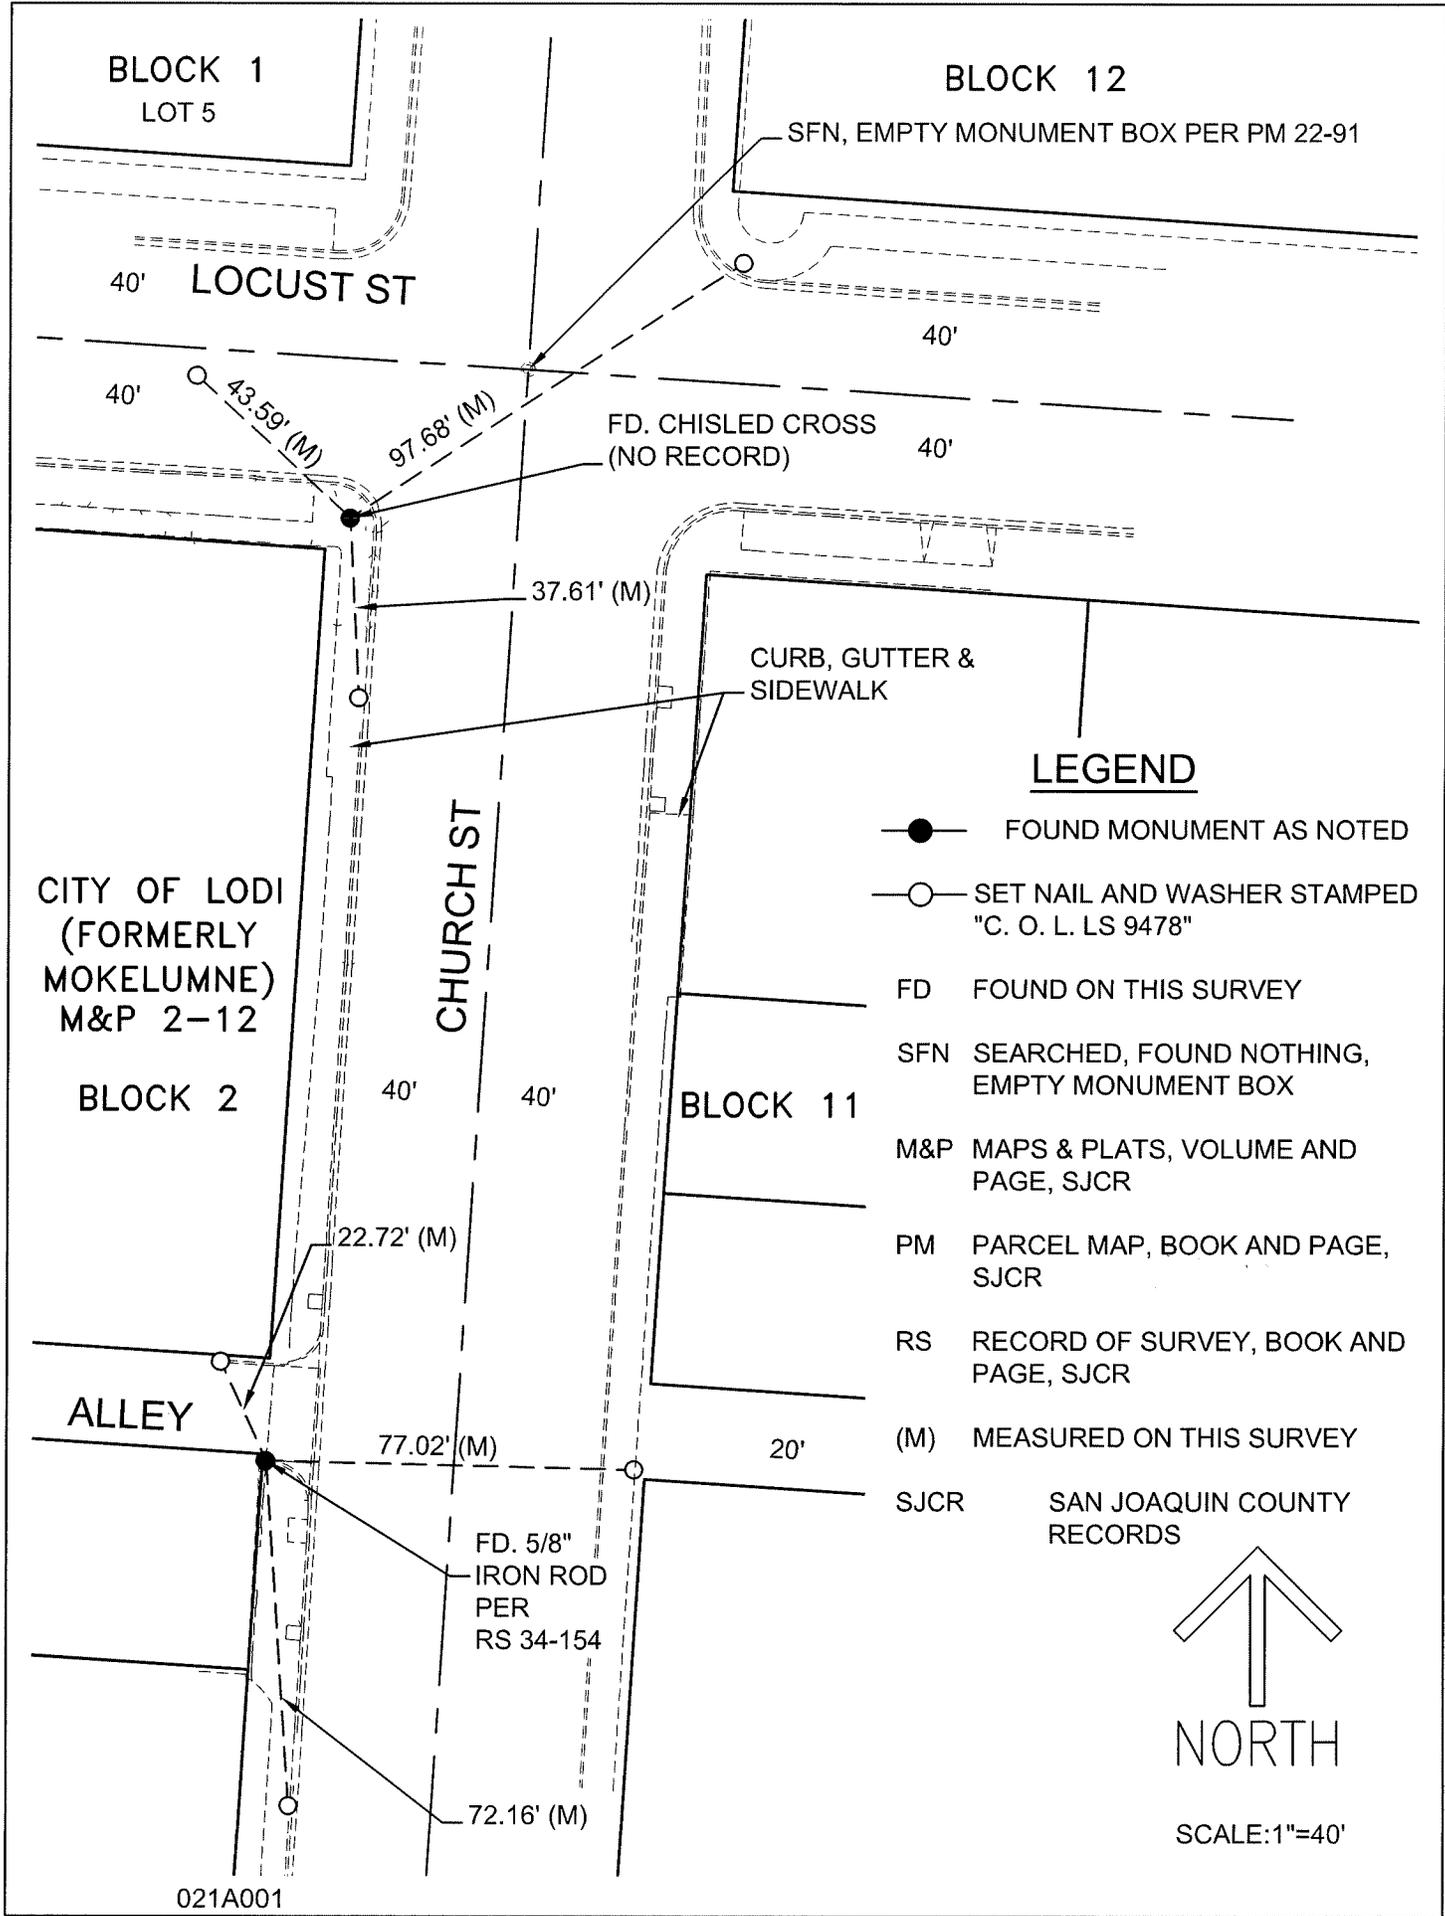

LEGEND

- FOUND MONUMENT AS NOTED
- SET NAIL AND WASHER STAMPED "C. O. L. LS 9478"
- FD FOUND ON THIS SURVEY
- SFN SEARCHED, FOUND NOTHING, EMPTY MONUMENT BOX
- M&P MAPS & PLATS, VOLUME AND PAGE, SJCR
- PM PARCEL MAP, BOOK AND PAGE, SJCR
- RS RECORD OF SURVEY, BOOK AND PAGE, SJCR
- (M) MEASURED ON THIS SURVEY
- SJCR SAN JOAQUIN COUNTY RECORDS



SCALE: 1"=40'

021A001