

CORNER RECORD

Agency Index CR-21-072


Document Number _____

City of _____ County of San Joaquin, California

Brief Legal Description Monuments Opposite Point "G" per R.S. 5-194, S.J.C.R.

CORNER TYPE

COORDINATES (Optional)

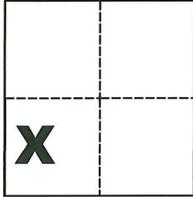

Government Corner Control
 Meander Property
 Rancho Other

N. _____ E. _____
 Elevation _____
 Units Metric U.S. Survey Foot
 Horizontal Datum _____
 Zone _____ Epoch Date _____
 Vertical Datum _____

Date of Survey May 10, 2021

Complies with Public Resources Code §§8801-8819
 Complies with Public Resources Code §§8890-8902

Sec. 13, T.1S., R.5E.,
 M.D.B. & M.

PLS Act Ref.: 8765(d) 8771 8773 Other:
 Corner/Monument: Left as found Established Rebuilt Pre-Construction
 Found and tagged Reestablished Referenced Post-Construction

Narrative of corner identified and monument as found, set, reset, replaced, or removed:

See sheet #2 for description(s):

SURVEYOR'S STATEMENT

This Corner Record was prepared by me or under my direction in conformance with

the Professional Land Surveyors' Act on May 13, 2021

Signed Michael L. Quatao P.L.S. or R.C.E. No. L.S. 4450



COUNTY SURVEYOR'S STATEMENT

This Corner Record was received May 14, 2021

and examined and filed June 8, 2021

Signed James E. Hart P.L.S. or R.C.E. No. 8657

Title County Surveyor


County Surveyor's Comment



PARCEL NO. 2
R.S. 5-194

UNFILED MAP BY CHAS. H. WIDDOWS, DATED
DECEMBER 1970, FILE NO. 8230

UNFILED MAP BY CHAS. H. WIDDOWS, DATED MARCH
1974, FILE NO. 12161

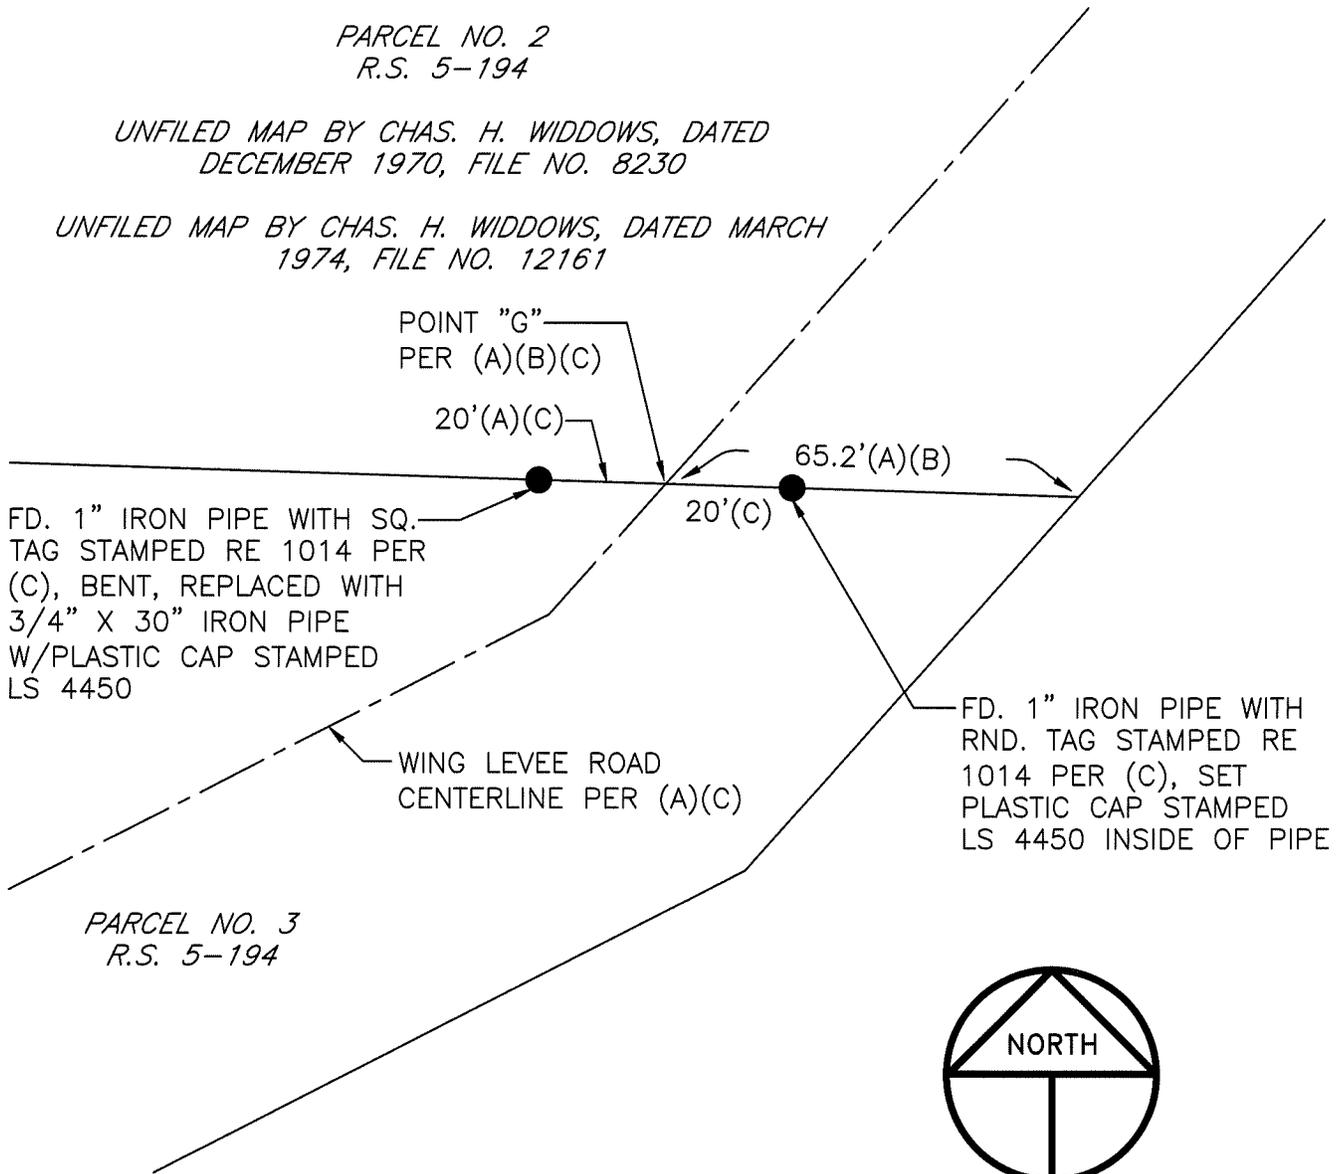


FD. 1" IRON PIPE WITH SQ. TAG STAMPED RE 1014 PER (C), BENT, REPLACED WITH 3/4" X 30" IRON PIPE W/PLASTIC CAP STAMPED LS 4450

WING LEVEE ROAD CENTERLINE PER (A)(C)

FD. 1" IRON PIPE WITH RND. TAG STAMPED RE 1014 PER (C), SET PLASTIC CAP STAMPED LS 4450 INSIDE OF PIPE

PARCEL NO. 3
R.S. 5-194

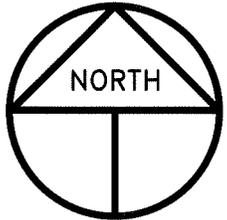

SCALE: 1" = 30'
2018-154 CR-2

REFERENCES

- (A) R.S. 5-194, S.J.C.R.
- (B) UNFILED MAP BY CHAS. H. WIDDOWS, DATED DECEMBER 1970, FILE NO. 8230.1, S.J.C.S.R.
- (C) UNFILED MAP BY CHAS. H. WIDDOWS, DATED MARCH 1974, FILE NO. 12161, S.J.C.S.R.

LEGEND

- INDICATES FOUND MONUMENT AS NOTED
- FD. INDICATES FOUND ON THIS SURVEY
- R.S. INDICATES RECORD OF SURVEY, BOOK AND PAGE, S.J.C.R.
- S.J.C.R. INDICATES SAN JOAQUIN COUNTY RECORDS
- S.J.C.S.R. INDICATES SAN JOAQUIN COUNTY SURVEYORS RECORDS