CORNER RECORD


Agency Index **Document Number** County of San Joaquin , California City of Brief Legal Description Northeasterly end of Parcel No. 2 per R.S. 5-194, S.J.C.R. **CORNER TYPE COORDINATES (Optional)** N. _ E. **Government Corner** Control Elevation U.S. Survey Foot Units Meander Property Other Rancho Horizontal Datum Zone Epoch Date Date of Survey May 10, 2021 Vertical Datum Complies with Public Resources Code §§8801-8819 Sec. 13, T.1S., R.5E., Complies with Public Resources Code §§8890-8902 M.D.B. & M. PLS Act Ref.: 8771 8765(d) 8773 Other: Left as found Established Rebuilt Pre-Construction Corner/ Monument: Found and tagged Reestablished Referenced Post-Construction Narrative of corner identified and monument as found, set, reset, replaced, or removed: ✓ See sheet #2 for description(s): SURVEYOR'S STATEMENT This Corner Record was prepared by me or under my direction in conformance with P.L.S. or R.C.E. No. L.S. 4450 **COUNTY SURVEYOR'S STATEMENT** This Corner Record was received and examined and filed

County Surveyor's Comment



Signed

Title

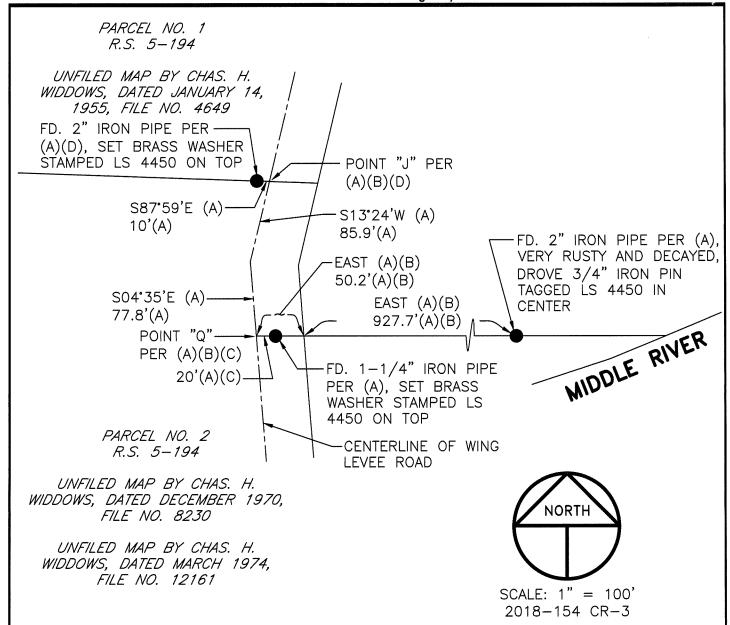

REFERENCES

- (A) R.S. 5-194, S.J.C.R.
- (B) UNFILED MAP BY CHAS. H. WIDDOWS, DATED DECEMBER 1970, FILE NO. 8230.1, S.J.C.S.R.
- (C) UNFILED MAP BY CHAS. H. WIDDOWS, DATED MARCH 1974, FILE NO. 12161, S.J.C.S.R.
- (D) UNFILED MAP BY CHAS. H. WIDDOWS, DATED JANUARY 14, 1955, FILE NO. 4649, S.J.C.S.R.

LEGEND

INDICATES FOUND MONUMENT AS NOTED

FD. INDICATES FOUND ON THIS SURVEY

R.S. INDICATES RECORD OF SURVEY, BOOK AND PAGE, S.J.C.R.

S.J.C.R. INDICATES SAN JOAQUIN COUNTY RECORDS

S.J.C.S.R. INDICATES SAN JOAQUIN COUNTY SURVEYORS RECORDS

BPELSG-2016 PAGE 2 OF 2