


CORNER RECORD

Agency Index CR-21-097
Document Number _____

City of Lodi County of San Joaquin, California
Brief Legal Description M.P. 43-140

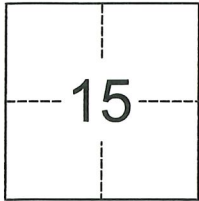

CORNER TYPE

Government Corner Control
Meander Property
Rancho Other

Date of Survey April 13, 2021

COORDINATES (Optional)

N. _____ E. _____

Elevation _____

Units Metric U.S. Survey Foot

Horizontal Datum _____

Zone _____ Epoch Date _____

Vertical Datum _____

Complies with Public Resources Code §§8801-8819

Complies with Public Resources Code §§8890-8902

T.3N., R.6E., M.D.B. & M.

PLS Act Ref.: 8765(d) 8771 8773 Other:

Corner/Monument: Left as found Established Rebuilt Pre-Construction

Found and tagged Reestablished Referenced Post-Construction

Narrative of corner identified and monument as found, set, reset, replaced, or removed:

See sheet #2 for description(s):

It is the purpose of this corner record to establish monuments per M.P. 43-140 that were found missing after construction.

SURVEYOR'S STATEMENT

This Corner Record was prepared by me or under my direction in conformance with

the Professional Land Surveyors' Act on April 27, 2021.

Signed [Signature] P.L.S. or R.C.E. No. 7889



COUNTY SURVEYOR'S STATEMENT

This Corner Record was received June 21, 2021

and examined and filed July 6, 2021.


Signed James E. Hart P.L.S. or R.C.E. No. 8657

Title County Surveyor

County Surveyor's Comment




S:\Projects\2015\15043-02\3_Drawings\15043-02_CR.dwg 06/16/21 3:54pm-ELSON-XREFS: 18x26_FM-RS-PM.DWG 08x11_bp_p.dwg

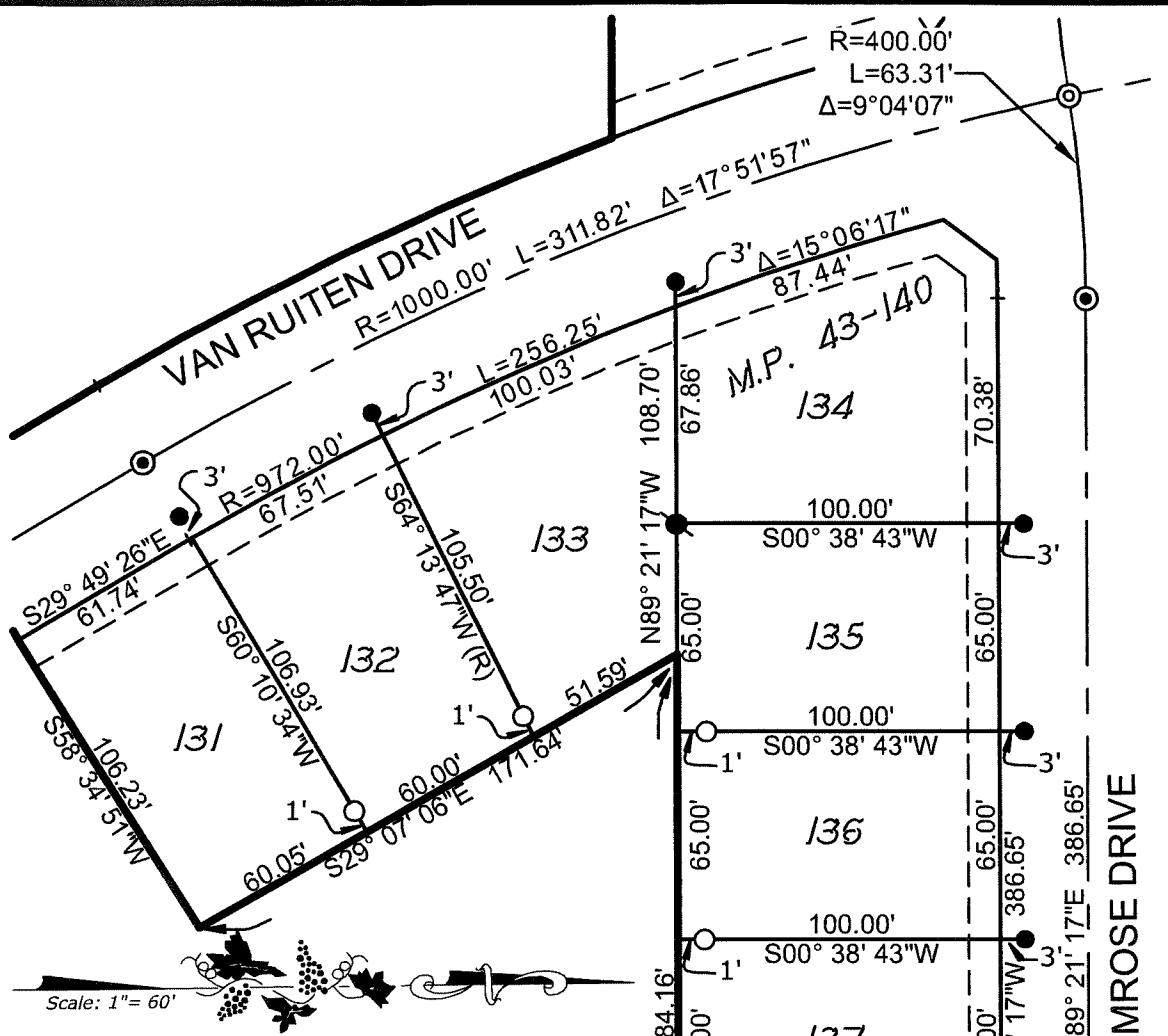

LEGEND:

- FOUND 3/4" IRON ROD, CAPPED AND STAMPED "BAUMBACH & PIAZZA ELSON PLS 7889" PER M.P. 43-140
- FOUND 1.25" DIAMETER BRASS DISK STAMPED "SURVEY LS 7889 PER M.P. 43-140
- SET 3/4"x30" IRON ROD, CAPPED AND STAMPED "BAUMBACH & PIAZZA ELSON PLS 7889"
- ⊙ FOUND 3/4" IRON ROD CAPPED & STAMPED "BAUMBACH & PIAZZA ELSON PLS 7889" IN MONUMENT BOX PER M.P. 43-140
- ⊙ SET MAG NAIL, HEAD BROKE OFF, SHANK ONLY

M.P. MAPS AND PLATS, SAN JOAQUIN COUNTY RECORDS
 DISTANCES ALONG LOT LINES THAT CONTAIN A WITNESS CORNER ARE FROM LOT CORNER TO LOT CORNER

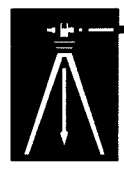

PREPARED IN THE OFFICE OF:
BAUMBACH & PIAZZA, INC.
 CIVIL ENGINEERS • SURVEYORS
 www.bpengineers.net
 323 W. Elm St.
 Lodi, CA 95240
 209.368.6618