


CORNER RECORD

Agency Index CR-21-104
 Document Number _____

City of Stockton County of San Joaquin, California
 Brief Legal Description Southwesterly corner of Lot 231 per M. & P. 30-50, S.J.C.R.

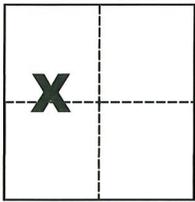

CORNER TYPE

Government Corner Control
 Meander Property
 Rancho Other

Date of Survey February 18, 2021

COORDINATES (Optional)

N. _____ E. _____
 Elevation _____
 Units Metric U.S. Survey Foot
 Horizontal Datum _____
 Zone _____ Epoch Date _____
 Vertical Datum _____
 Complies with Public Resources Code §§8801-8819
 Complies with Public Resources Code §§8890-8902

Sec. 7, T.2N., R.6E.,
 M.D.B. & M.

PLS Act Ref.: 8765(d) 8771 8773 Other:

Corner/Monument: Left as found Established Rebuilt Pre-Construction
 Found and tagged Reestablished Referenced Post-Construction

Narrative of corner identified and monument as found, set, reset, replaced, or removed:
 See sheet #2 for description(s):

SURVEYOR'S STATEMENT

This Corner Record was prepared by me or under my direction in conformance with
 the Professional Land Surveyors' Act on 6.15.2021

Signed Michael L. Quarles P.L.S. or R.C.E. No. L.S. 4450




COUNTY SURVEYOR'S STATEMENT

This Corner Record was received June 16, 2021
 and examined and filed July 6, 2021

Signed James E. Hart P.L.S. or R.C.E. No. 8657
 Title County Surveyor


County Surveyor's Comment



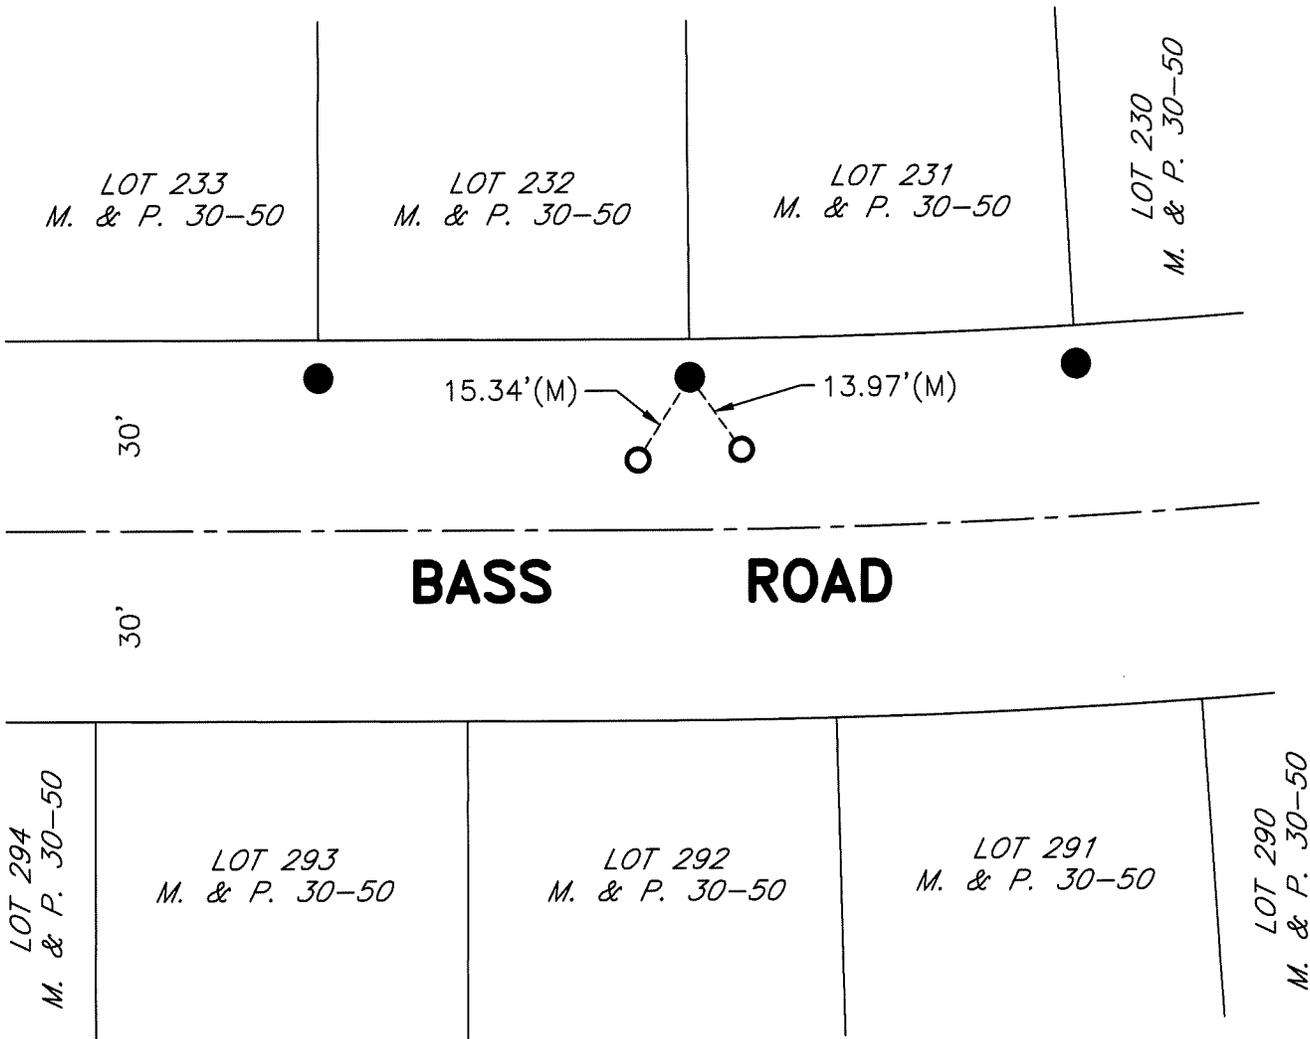

REFERENCE

(A) M. & P. 30-50, S.J.C.R.

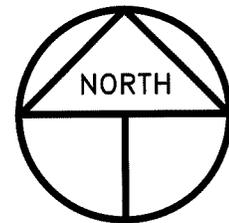

SCALE: 1" = 30'
2021-28

LEGEND

- INDICATES FOUND SAW CUT CROSS PER (A)
- INDICATES SET CONCRETE NAIL AND TAG STAMPED LS 4450
- M. & P. INDICATES MAPS AND PLATS, VOLUME AND PAGE, S.J.C.R.
- S.J.C.R. INDICATES SAN JOAQUIN COUNTY RECORDS
- (M) INDICATES MEASURED ON THIS SURVEY