
## **CORNER RECORD** Agency Index **Document Number** California County of San Joaquin City of **Brief Legal Description** Southeast corner of Lot 11, P.M. 11-158 **COORDINATES (Optional) CORNER TYPE** N. **Government Corner** Elevation Control X U.S. Survey Foot Units Metric Meander **Property** Rancho Other **Horizontal Datum Epoch Date** Zone Date of Survey March 11, 2021 Vertical Datum Complies with Public Resources Code §§8801-8819 Complies with Public Resources Code §§8890-8902 T.5N., R.9E., M.D.B.M. PLS Act Ref.: 8765(d) 8771 8773 Other: Pre-Construction Left as found Established Rebuilt Corner/ **Monument:** Reestablished Post-Construction Found and tagged Referenced Narrative of comer identified and monument as found, set, reset, replaced, or removed: See sheet #2 for description(s): **SURVEYOR'S STATEMENT** This Corner Record was prepared by me or under my direction in conformance with the Professional Land Surveyors' Act on Signed

**COUNTY SURVEYOR'S STATEMENT** 

This Corner Record was received June 29, 2021
and examined and filed July 13, 2021
Signed James & Hart P.L.S. er R.C.E. No. 8657
Title County Surveyor
County Surveyor's Comment

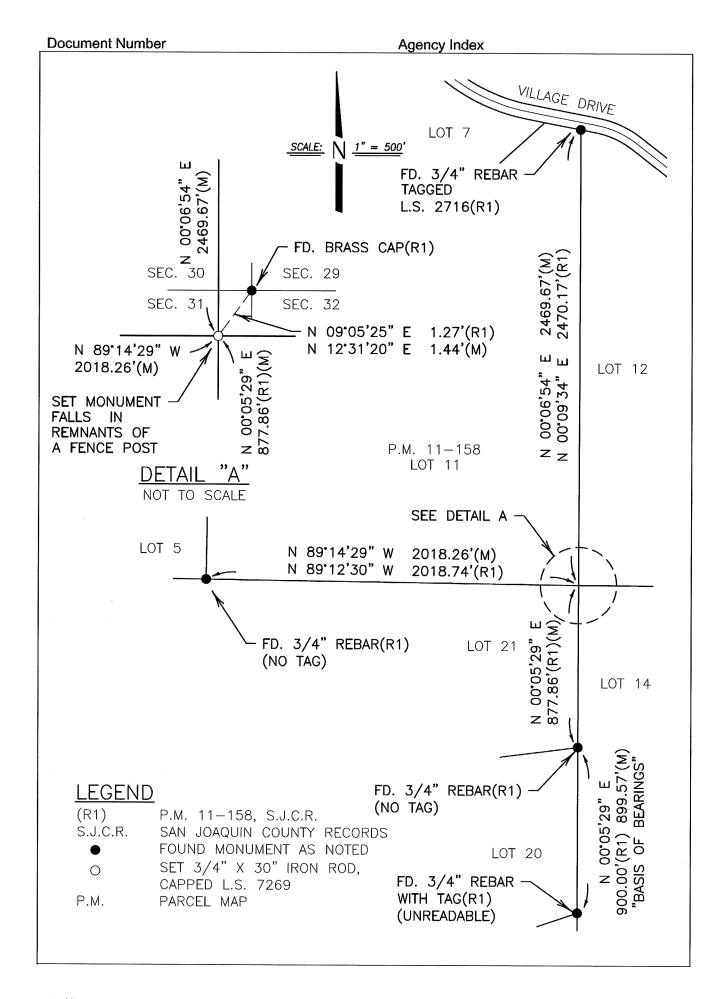



BPELSG-2016 Page 2 of 2