


CORNER RECORD

Agency Index CR-21-108
Document Number _____

City of _____ County of San Joaquin, California
Brief Legal Description Parcel 3, per P.M. 24-67, San Joaquin County Records

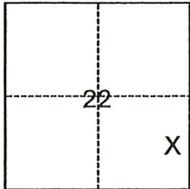

T.3N. R.8E.
M.D.B.&M.

CORNER TYPE

- Government Corner
- Meander
- Rancho
- Control
- Property
- Other

Date of Survey June 7, 2021

COORDINATES (Optional)

N. _____ E. _____

Elevation _____

Units Metric U.S. Survey Foot

Horizontal Datum _____

Zone _____ Epoch Date _____

Vertical Datum _____

Complies with Public Resources Code §§8801-8819

Complies with Public Resources Code §§8890-8902

PLS Act Ref.: 8765(d) 8771 8773 Other:

Corner/Monument: Left as found Established Rebuilt Pre-Construction

Found and tagged Reestablished Referenced Post-Construction

Narrative of corner identified and monument as found, set, reset, replaced, or removed:

See sheet #2 for description(s):

SURVEYOR'S STATEMENT

This Corner Record was prepared by me or under my direction in conformance with
the Professional Land Surveyors' Act on June 25, 2021

Signed [Signature] P.L.S. or R.C.E. No. 7269



COUNTY SURVEYOR'S STATEMENT

This Corner Record was received June 29, 2021

and examined and filed July 13, 2021

Signed James E. Hart P.L.S. or R.C.E. No. 8657


Title County Surveyor

County Surveyor's Comment





SCALE: NOT TO SCALE

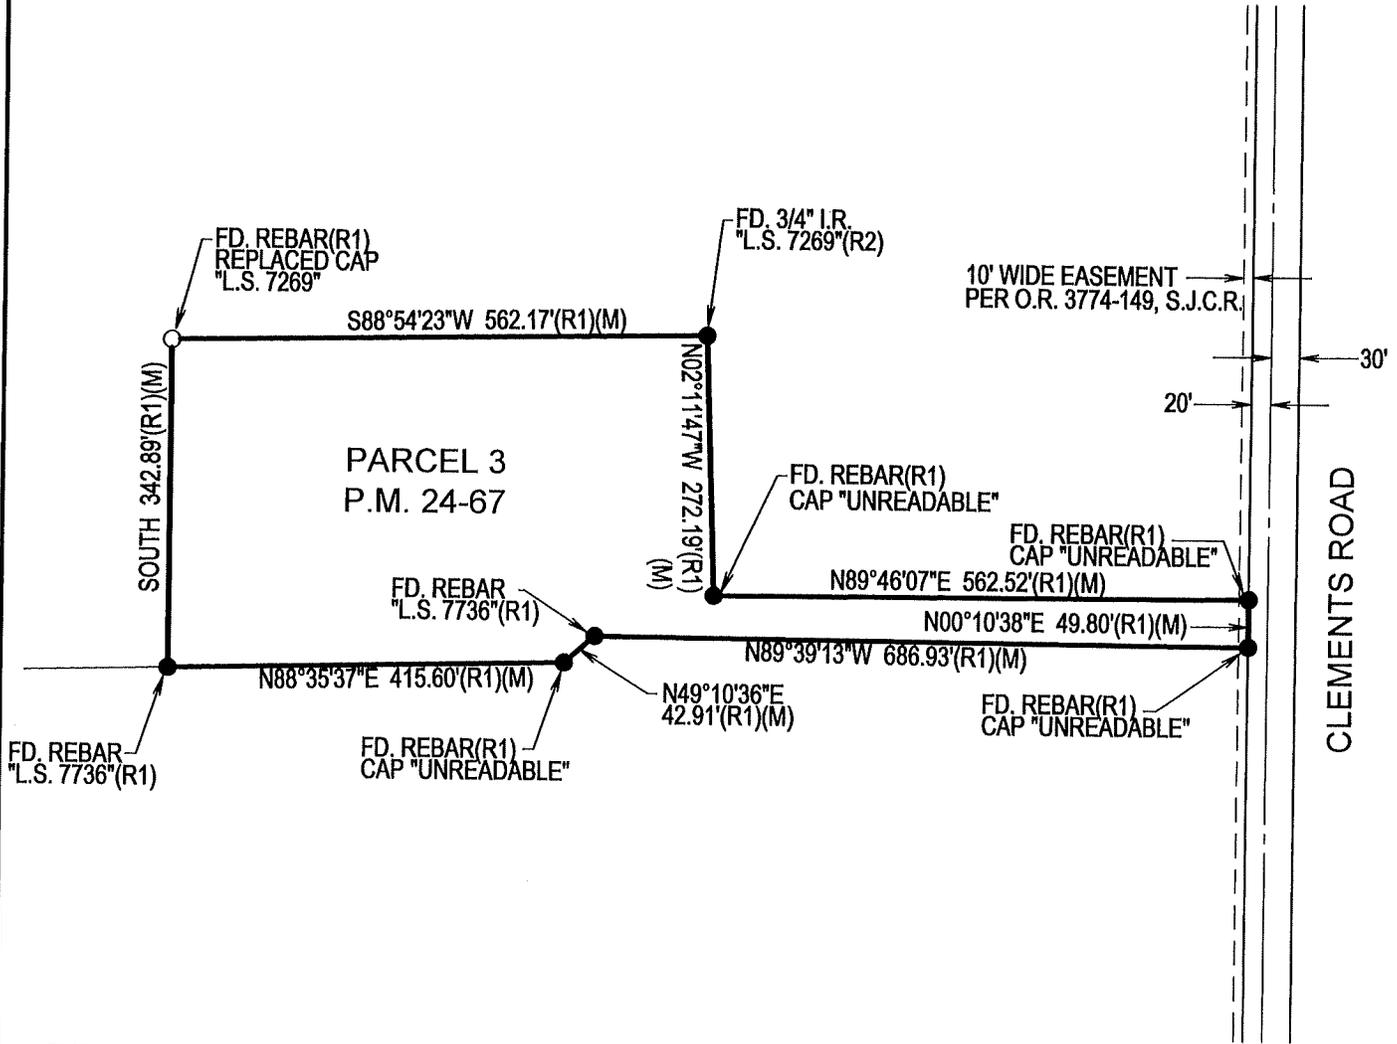

REFERENCES

- (R1) P.M. 24-67, S.J.C.R.
- (R2) C.R. 20-204, SAN JOAQUIN COUNTY SURVEYOR'S RECORDS

LEGEND

- FD. FOUND
- C.R. CORNER RECORD
- S.J.C.R. SAN JOAQUIN COUNTY RECORDS
- P.M. PARCEL MAPS
- (M) MEASURED
- O.R. OFFICIAL RECORDS
- I.R. IRON ROD
- SET 3/4" X 30" IRON ROD
CAPPED "L.S. 7269" OR AS NOTED
- FOUND MONUMENT
AS NOTED