

# CORNER RECORD


Agency Index CR-123

Document Number \_\_\_\_\_

City of Ripon County of San Joaquin, California

Brief Legal Description NGS Benchmark P-799 (HS 0217)

### CORNER TYPE

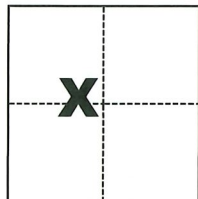

- Government Corner     Control  
 Meander                     Property  
 Rancho                          Other

Date of Survey February 22, 2021

Sec. 19, T.2S., R.8E.,  
M.D.B. & M.

### COORDINATES (Optional)

N. 2094908 Ft.                    E. 6378373 Ft.

Elevation \_\_\_\_\_

Units                     Metric                     U.S. Survey Foot

Horizontal Datum NAD83

Zone SPC-3                    Epoch Date \_\_\_\_\_

Vertical Datum \_\_\_\_\_

Complies with Public Resources Code §§8801-8819

Complies with Public Resources Code §§8890-8902

PLS Act Ref.:     8765(d)                     8771                     8773                     Other:

Corner/                     Left as found                     Established                     Rebuilt                     Pre-Construction

Monument:                     Found and tagged                     Reestablished                     Referenced                     Post-Construction

Narrative of corner identified and monument as found, set, reset, replaced, or removed:

See sheet #2 for description(s):

SPC - 3 coordinates listed are the result of Post Processing (differentially correcting) data that was logged from an Ashtech Mobile Mapper 10 handheld GPS receiver and are in the sub-meter accuracy range.

These Geodetic and Grid coordinates are provided for the purpose of facilitating locating the monument

Found as described in NGS Datasheet for P-799 (PID HS 0217)

### SURVEYOR'S STATEMENT

This Corner Record was prepared by me or under my direction in conformance with

the Professional Land Surveyors' Act on Aug. 17, 2021

Signed Michael L. Quarantoli P.L.S. or R.C.E. No. L.S. 4450



### COUNTY SURVEYOR'S STATEMENT

This Corner Record was received August 26, 2021


and examined and filed September 13, 2021

Signed James E. Hart P.L.S. or R.C.E. No. 8657

Title County Surveyor

County Surveyor's Comment



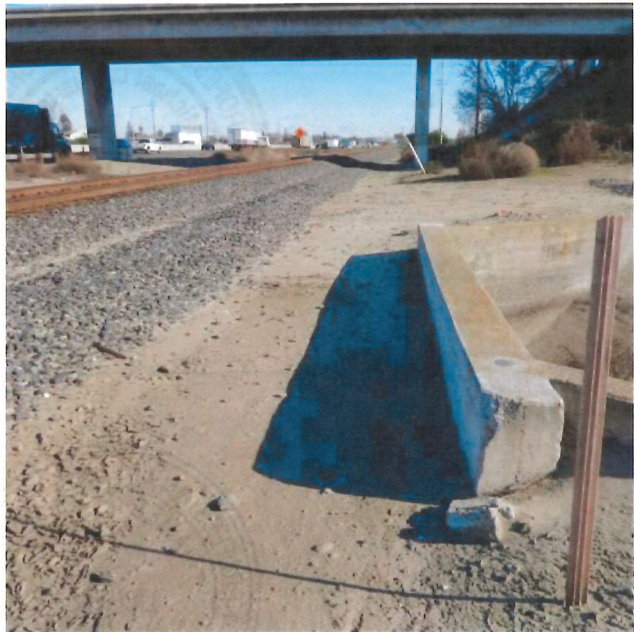

Northerly end of concrete Irrigation Canal Headwall Southwest of the Union Pacific Railroad road and just north of the Fulton Avenue Bridge over Hwy 99.