


CORNER RECORD

Agency Index CR-21-130
Document Number _____

City of Manteca County of San Joaquin, California
Brief Legal Description NGS Benchmark F-799 (HS 0202)

CORNER TYPE

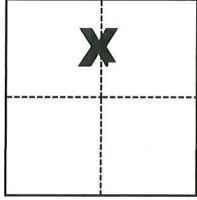

- Government Corner
- Meander
- Rancho
- Control
- Property
- Other

Date of Survey March 13, 2021

Sec. 31, T.1S., R.7E.,
M.D.B. & M.

COORDINATES (Optional)

N. 2118909 Ft. E. 6346572 Ft.

Elevation _____

Units Metric U.S. Survey Foot

Horizontal Datum NAD83

Zone SPC-3 Epoch Date _____

Vertical Datum _____

Complies with Public Resources Code §§8801-8819

Complies with Public Resources Code §§8890-8902

PLS Act Ref.: 8765(d) 8771 8773 Other:

Corner/Monument: Left as found Established Rebuilt Pre-Construction

Found and tagged Reestablished Referenced Post-Construction

Narrative of corner identified and monument as found, set, reset, replaced, or removed:

See sheet #2 for description(s):

SPC - 3 coordinates listed are the result of Post Processing (differentially correcting) data that was logged from an Ashtech Mobile Mapper 10 handheld GPS receiver and are in the sub-meter accuracy range.

These Geodetic and Grid coordinates are provided for the purpose of facilitating locating the monument

Found as described in NGS Datasheet for S-995 (PID HS 0135)

SURVEYOR'S STATEMENT

This Corner Record was prepared by me or under my direction in conformance with

the Professional Land Surveyors' Act on Aug. 17, 2021

Signed Michael L. Quattaroni P.L.S. or R.C.E. No. L.S. 4450



COUNTY SURVEYOR'S STATEMENT

This Corner Record was received August 26, 2021


and examined and filed September 13, 2021

Signed James E. Hart P.L.S. or R.C.E. No. 8657

Title County Surveyor

County Surveyor's Comment



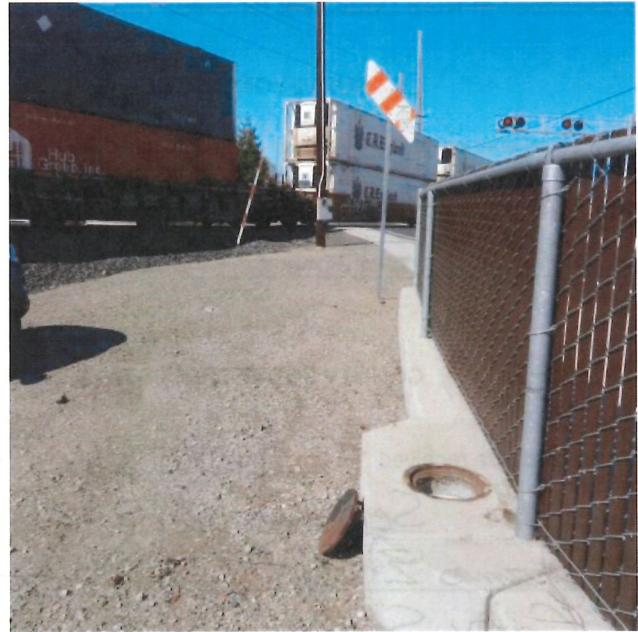

Southeast corner of intersection of the Louise Avenue and Union Pacific Railroad crossing.