


CORNER RECORD

Agency Index CR-21-166
 Document Number _____

City of _____ County of San Joaquin, California
 Brief Legal Description Parcel 1-4, per P.M. 21-195, San Joaquin County Records.

CORNER TYPE

COORDINATES (Optional)

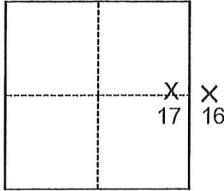

- Government Corner
- Meander
- Rancho
- Control
- Property
- Other

Date of Survey September 10, 2021

N. _____ E. _____
 Elevation _____
 Units Metric U.S. Survey Foot
 Horizontal Datum _____
 Zone _____ Epoch Date _____
 Vertical Datum _____
 Complies with Public Resources Code §§8801-8819
 Complies with Public Resources Code §§8890-8902

T.4N., R.9E. M.D.B.&M.

- PLS Act Ref.: 8765(d) 8771 8773 Other:
- Corner/Monument: Left as found Established Rebuilt Pre-Construction
 Found and tagged Reestablished Referenced Post-Construction

Narrative of corner identified and monument as found, set, reset, replaced, or removed:
 See sheet #2 for description(s):

SURVEYOR'S STATEMENT

This Corner Record was prepared by me or under my direction in conformance with
 the Professional Land Surveyors' Act on September 14, 2021
 Signed [Signature] (P.L.S.) or R.C.E. No. 7269




COUNTY SURVEYOR'S STATEMENT

This Corner Record was received September 15, 2021
 and examined and filed October 1, 2021
 Signed James E. Hart P.L.S. or R.C.E. No. 8657
 Title County Surveyor



County Surveyor's Comment

SCALE: NOT TO SCALE

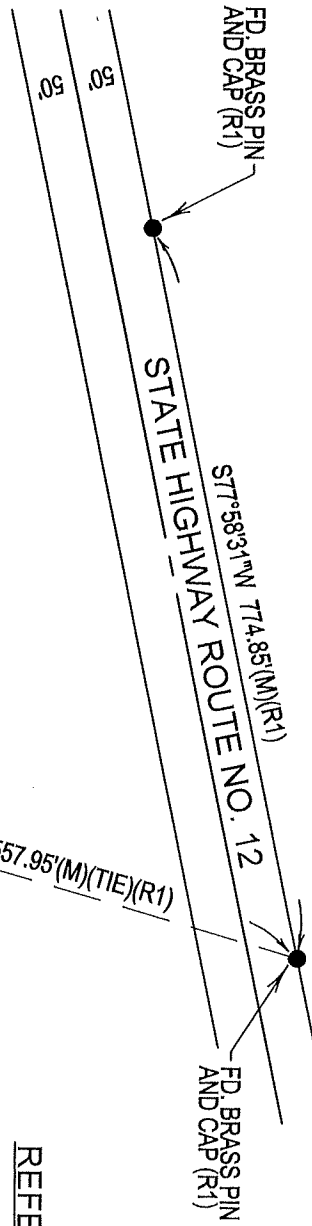

- LEGEND**
- FOUND
 - FOUND
 - X— DIMENSION POINT, NOTHING FOUND OR SET
- FD. FOUND
S.J.C.R. SAN JOAQUIN COUNTY RECORDS
P.M. PARCEL MAPS
(M) MEASURED
- SET 3/4" X 30" IRON ROD
 - CAPPED "L.S. 7269" OR AS NOTED
 - FOUND MONUMENT
 - X— AS NOTED

REFERENCES

(R1) P.M. 21-195, S.J.C.R.

