
Agency Index <u>CR-21-205</u> **CORNER RECORD** Document Number \_\_\_\_\_ City of STOCKTON County of SAN JOAQUIN Brief Legal Description <u>RIGHT-OF-WAY MONUMENT NEAR E LINDSAY ST & N SAN JOAQUIN ST</u> **CORNER TYPE COORDINATES (Optional)** Government Corner Control Metric U.S. Survey Foot  $\boxtimes$ Property Meander -SEC. 20-Horizontal Datum Other Rancho Zone \_\_\_\_\_ Epoch Date \_ Vertical Datum: \_\_\_ Date of Survey \_2021-04-07 C.M. WEBER Complies with Public Resources Code §§8801-8819 **GRANT** Complies with Public Resources Code §\$8890-8902 8765(d) PLS Act Ref .:  $\boxtimes$ 8771 8773 Other: Corner/ Left as found Established Rebuilt Pre-Construction Monument: Found and tagged Reestablished Referenced Post-Construction Narrative of corner identified and monument as found, set, reset, replaced, or removed: See sheet #2 for description(s):

SURVEYOR'S STATEMENT  This Corner Record was prepared by me or under my direction in conformance with the Professional Land Surveyor's Act on	No. 8366 Exp. 12-31-2021
This Corner Record was received November 5, 2021 and examined and filed December 2, 2021.  Signed December 2 P.L.S. or R.C.E. No.: 8657  Title County Surveyor  County Surveyor's Comment	LICENSE No. 8657

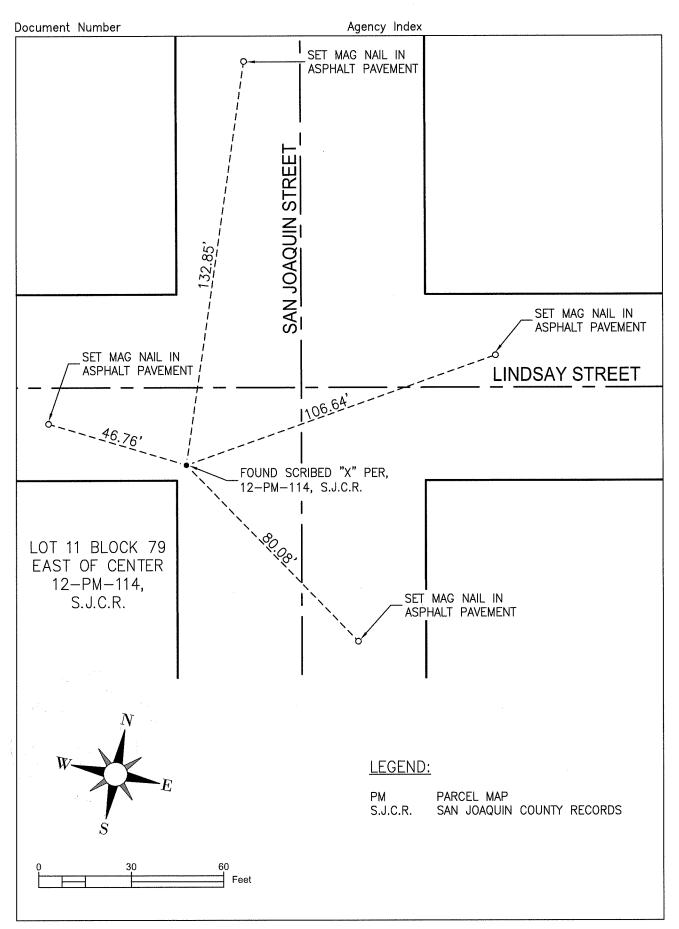

Page 2 of 2