


CORNER RECORD

Agency Index: CR-21-212

Document Number: _____

City of STOCKTON County of SAN JOAQUIN, California

Brief Legal Description FOUND MONUMENT ON MANTHEY ROAD

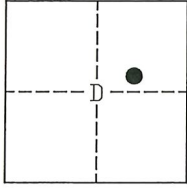

C.M. WEBER GRANT

CORNER TYPE

- Government Corner
- Meander
- Rancho
- Control
- Property
- Other

Date of Survey 09-20-2021

COORDINATES (Optional)

- N. _____ E. _____
- Elevation _____
- Units Metric U.S. Survey Foot
- Horizontal Datum _____
- Zone _____ Epoch Date _____
- Vertical Datum _____
- Complies with Public Resources Code SS8801-8819
- Complies with Public Resources Code SS8890-8902

PLS Act Ref: 8765(d) 8771 8773 Other:

Corner/Monument: Left as found Established Rebuilt Pre-Construction
 Found and Tagged Reestablished Referenced Post-Construction

Narrative of corner identified and monument as found, set, reset, replaced, or removed:

See sheet #2 for description(s):

FOUND ONE (1) NAIL IN WASHER STAMPED "CALTRANS R/W L.S. 8265" ON MANTHEY ROAD AS SHOWN ON MAP FILED FOR RECORD IN BOOK 38 OF SURVEYS, AT PAGE 136, S.J.C.R. SET THREE (3) NAILS WITH BRASS TAG "L.S. 6953" AS WITNESS CORNERS, ALL AS SHOWN ON PAGE 2.

SURVEYOR'S STATEMENT

This Corner Record was prepared by me or under my direction in conformance with the Land Surveyors' Act on SEPTEMBER 30, 2021,



Signed [Signature] P.L.S. or R.C.E. Number 6953

COUNTY SURVEYOR'S STATEMENT

This Corner Record was received November 12, 2021


and examined and filed December 3, 2021

Signed James E. Hart P.L.S. or R.C.E. No: 8657

Title County Surveyor



County Surveyor's Comment _____

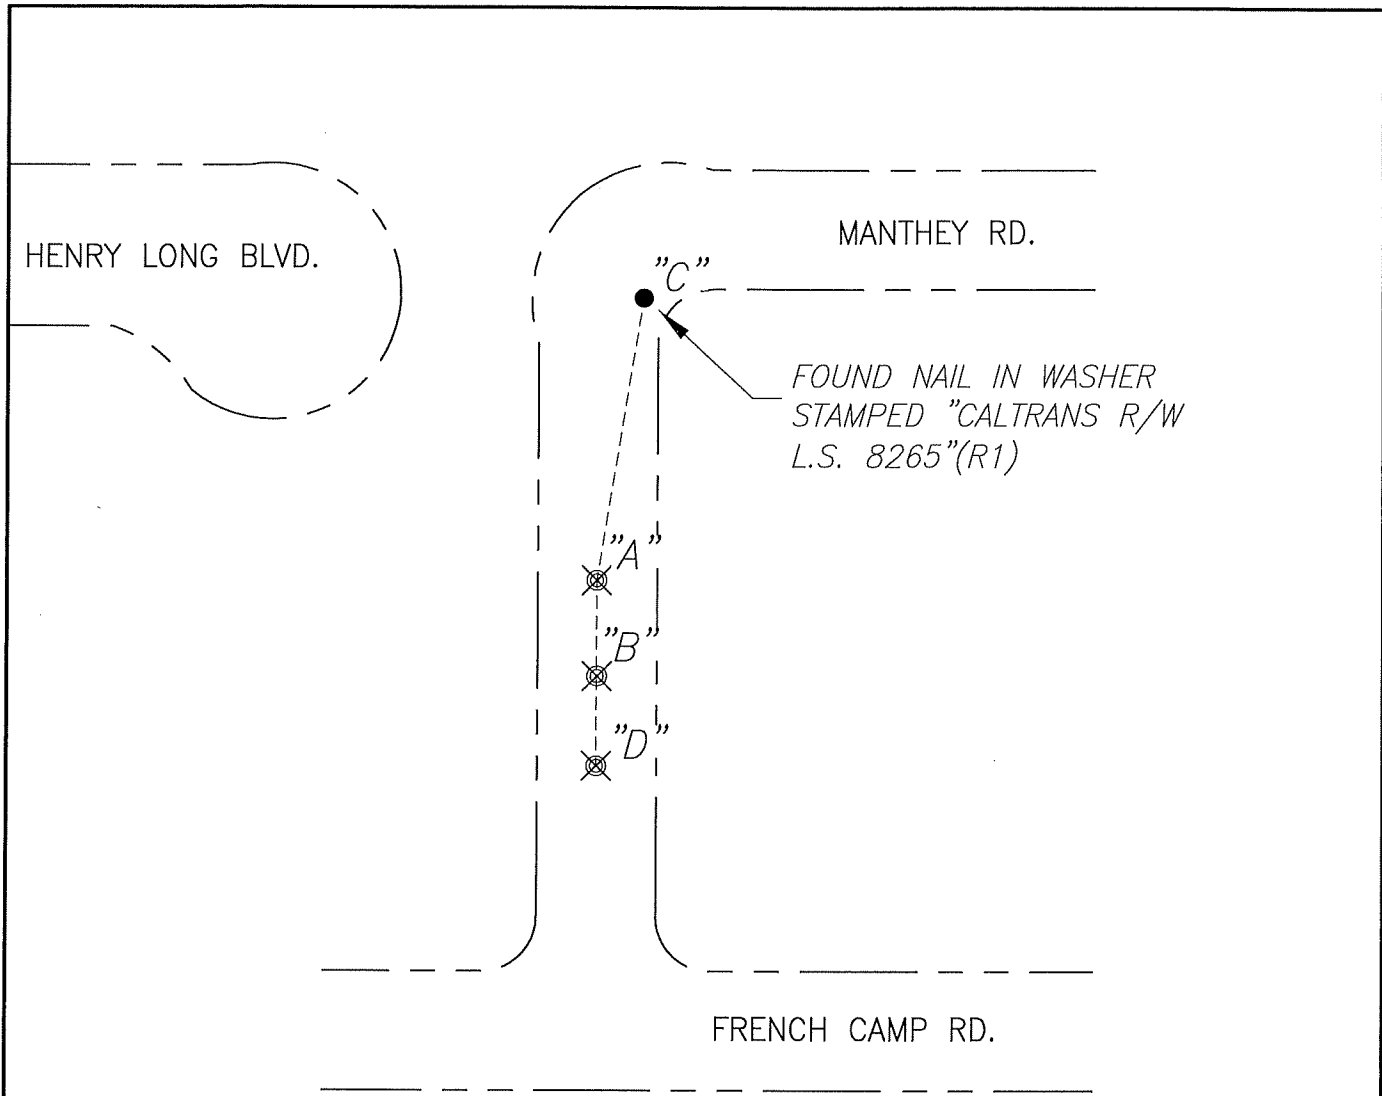

∠ AND DISTANCE TABLE

<i>BS-@-FS</i>	<i>∠</i>	<i>FS DISTANCE</i>
<i>D-A-D</i>	<i>00°00'00"</i>	<i>100.95'(M)</i>
<i>D-A-B</i>	<i>359°51'35"</i>	<i>52.04'(M)</i>
<i>D-A-C</i>	<i>189°19'34"</i>	<i>155.65'(M)</i>

LEGEND:

- ⊗ SET NAIL WITH BRASS TAG "L.S. 6953"
- FOUND MONUMENT AS NOTED
- (M) MEASURED DISTANCE. ALL DISTANCES ARE MEASURED UNLESS NOTED OTHERWISE.
- S- DENOTES RECORD OF SURVEY, BOOK & PAGE, S.J.C.R.
- S.J.C.R. DENOTES SAN JOAQUIN COUNTY RECORDS



NOT TO SCALE

REFERENCE:

(R1) 38-S-136, S.J.C.R.