


CORNER RECORD

Agency Index: CR-21-227
Document Number: _____
County of SAN JOAQUIN, California

City of STOCKTON
Brief Legal Description FOUND MONUMENT ON CHAUNCY CIRCLE

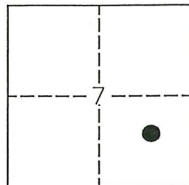

T.2N, R.6E

CORNER TYPE

- Government Corner
- Meander
- Rancho
- Control
- Property
- Other

Date of Survey 09-27-2021

COORDINATES (Optional)

N. _____ E. _____
 Elevation _____
 Units Metric U.S. Survey Foot
 Horizontal Datum _____
 Zone _____ Epoch Date _____
 Vertical Datum _____
 Complies with Public Resources Code SS8801-8819
 Complies with Public Resources Code SS8890-8902

- PLS Act Ref: 8765(d) 8771 8773 Other: _____
- Corner/Monument: Left as found Established Rebuilt Pre-Construction
 Found and Tagged Reestablished Referenced Post-Construction

Narrative of corner identified and monument as found, set, reset, replaced, or removed:

See sheet #2 for description(s):

FOUND ONE (1) CHISELED CROSS ON THE WEST SIDE OF CHAUNCY CIRCLE WITH NO REFERENCE. SET
THREE (3) CONCRETE NAILS WITH BRASS TAG "L.S. 6953" AS WITNESS CORNERS, ALL AS SHOWN ON
PAGE 2.

SURVEYOR'S STATEMENT

This Corner Record was prepared by me or under my direction in conformance with the Land Surveyors' Act on OCTOBER 1, 2021,

Signed [Signature] P.L.S. or R.C.E. Number 6953



COUNTY SURVEYOR'S STATEMENT


This Corner Record was received December 6, 2021

and examined and filed December 20, 2021

Signed James E. Hart P.L.S. or R.C.E. No: 8657
 Title County Surveyor



County Surveyor's Comment _____

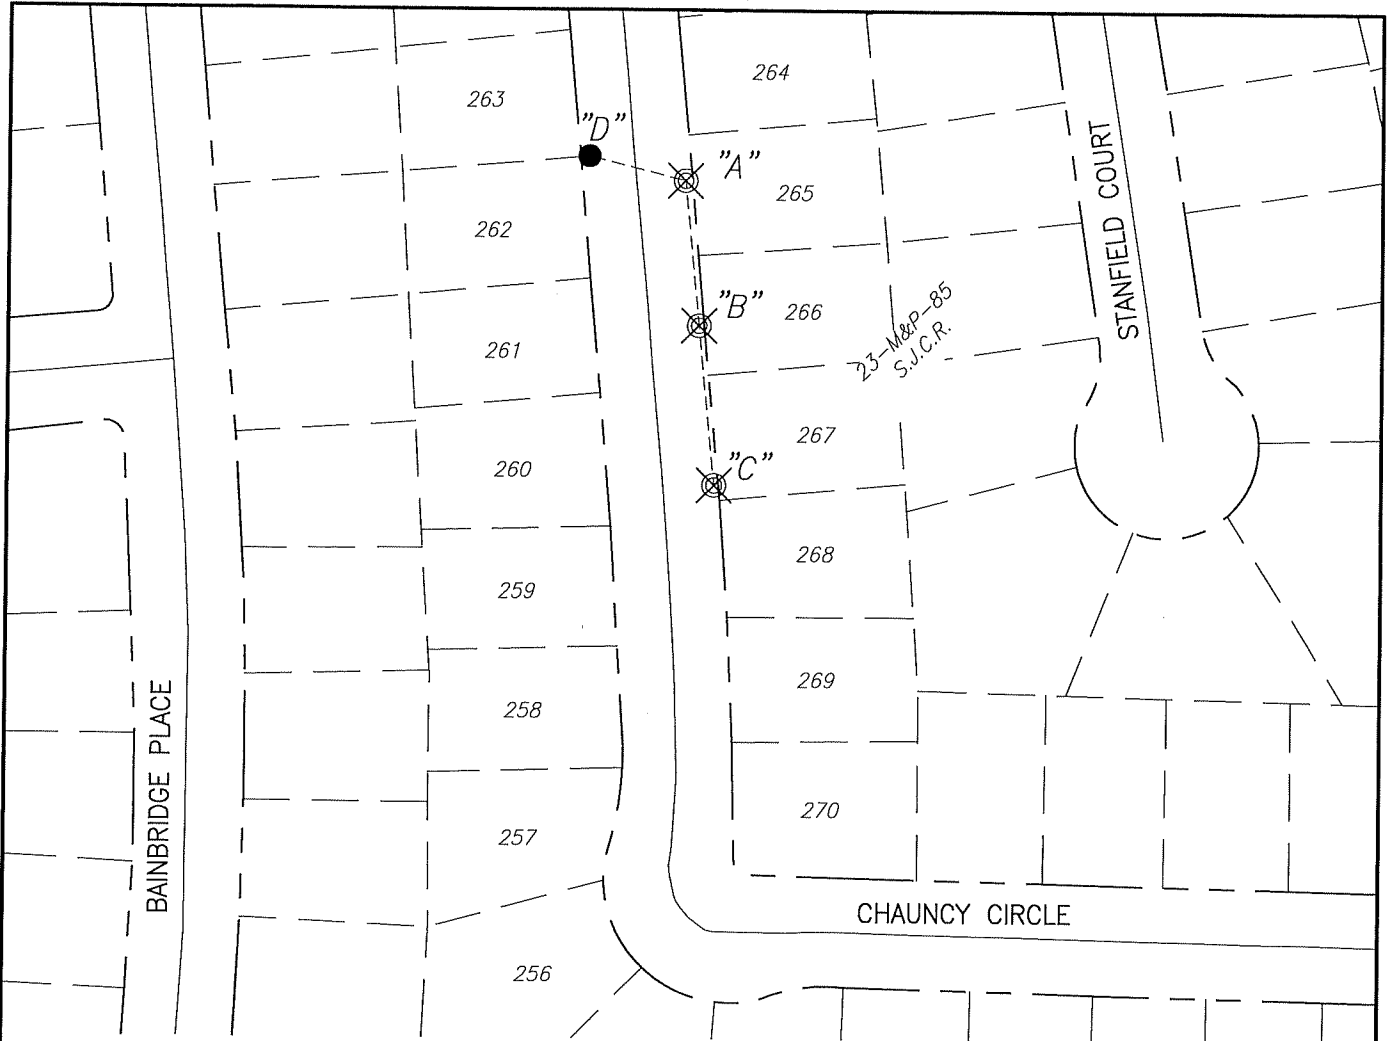

BS-@-FS	⚓	FS DISTANCE
C-A-B	00°00'00"	79.32'(M)
C-A-C	00°00'00"	166.51'(M)
C-A-D	109°08'15"	49.64'(M)

LEGEND:

- ⊗ SET CONCRETE NAIL WITH BRASS TAG "L.S. 6953"
- FOUND CHISELED CROSS IN SIDEWALK
- S.J.C.R. SAN JOAQUIN COUNTY RECORDS
- M&P- MAPS & PLATS
- (M) MEASURED DISTANCE. ALL DISTANCES ARE MEASURED UNLESS NOTED OTHERWISE.

NOT TO SCALE