

CR-21-232 Agency Index: CORNER RECORD Document Number: County of SAN JOAQUIN, California STOCKTON Brief Legal Description FOUND MONUMENT ON ALPINE AVENUE COORDINATES (Optional) CORNER TYPE E. _ Government Corner Control Elevation Property Meander U.S. Survey Foot ☐ Metric Units ○ Other Rancho Horizontal Datum Zone _____ Epoch Date ____ 09-28-2021 Date of Survey Vertical Datum CAMPO DE Complies with Public Resources Code SS8801-8819 LOS FRANCESES Complies with Public Resources Code SS8890-8902 8773 Other: PLS Act Ref: 8765(d) 8771 □ Pre − Construction Established Rebuilt ∠Left as found Corner/ Post-Construction Referenced Monument: Found and Tagged Reestablished Narrative of corner identified and monument as found, set, reset, replaced, or removed: See sheet #2 for description(s): FOUND ONE (1) CHISELED CROSS WITH NO REFERENCE ON THE NORTH SIDE OF ALPINE AVENUE. SET THREE (3) CONCRETE NAILS WITH BRASS TAG "L.S. 6953" AS WITNESS CORNERS, ALL AS SHOWN ON PAGE 2. SURVEYOR'S STATEMENT This Corner Record was prepared by me or under my direction in conformance with KENT A. HYSELL the Land Surveyors' Act on ______OCTOBER 1 _____, __2021 __, ND, 6953 P.L.S. or R.C.E. Number 6953 COUNTY SURVEYOR'S STATEMENT This Corner Record was received December 6, 2021 and examined and filed December 20, 2021 times & Hart P.L.S. or R.C.E. No: 8657 County Surveyor's Comment _____

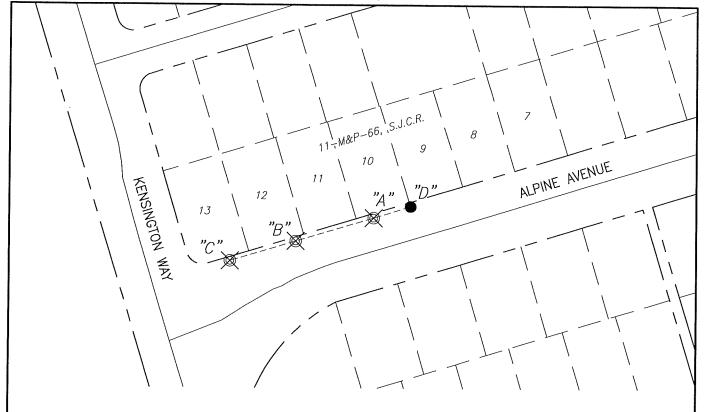

¾ AND DISTANCE TABLE		
BS-@-FS	¥	FS DISTANCE
C-A-B	00'00'00"	88.70'(M)
C-A-C	00'00'00"	164.12'(M)
C-A-D	179*27'25"	41.98'(M)

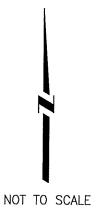

LEGEND:

SET CONCRETE NAIL WITH BRASS TAG "L.S. 6953"

FOUND CHISELED CROSS IN SIDEWALK

S.J.C.R. SAN JOAQUIN COUNTY RECORDS

-M&P- MAPS & PLATS

(M) MEASURED DISTANCE. ALL DISTANCES ARE MEASURED UNLESS NOTED OTHERWISE.