COP	NER REC	OPD	Agency Index	CR-21-236
COR	MEKKE	JOND	Document Number	
City of	Lodi	County of _	San Joac	quin, California
Brief Legal Descript	tion Property mor	numents at Church	Street & Locust Stre	eet, Section 1, T3N, R6E
CORNER TYPE		COORDINATES (Optional)		
X	Government C	orner Control	N Elevation	E
	Meander	Property	Units Metric	X U.S. Survey Foot
	Rancho	Other	Horizontal Datum	
	_		ZoneEpoch Date	
	Date of Survey	August 30, 2021	Vertical Datum	
Section 1 , T.3N.,R.6E.M.D.B.&M.			Complies with Public Resources Code §§8801-8819 Complies with Public Resources Code §§8890-8902	
PLS Act Ref.:	8765(d)	8771	8773	Other:
Corner/	Left as found	Established	Rebuilt	Pre-Construction
Monument:	Found and tagged	Reestablished	Referenced	X Post-Construction
Narrative of corner identified and monument as found, set, reset, replaced, or removed:  See sheet #2 for description(s):				
FOUND 5/8" IRON ROD PER RS 34-154 AT CHURCH STREET & ALLEY SOUTH OF LOCUST				
STREET. FOUND CHISELED CROSS AT CHURCH STREET & LOCUST STREET (NO RECORD).				
RESET UNTAGGED CHISELED CROSS AT ORIGINAL LOCATION PER RS 34-154. DID NOT RESET				
CHISELED CROSS OF NO RECORD AT CHURCH STREET AND LOCUST STREET. NO BOUNDARY ANALYSIS WAS PERFORMED.				
SURVEYOR'S STATEMENT				
This Corner Record was prepared by me or under my direction in conformance with				
the Professional Land Surveyors' Act on Avvember 30, 2021.				
Signed P.L.S. or <del>R.C.E. No.</del> 9478				
0-0				OF CALLEDRALE

**COUNTY SURVEYOR'S STATEMENT** 

and filed <u>December 10, 2021</u>

James E Hout P.L.S. OFR.C.E. No. 8657

**County Surveyor's Comment** 


This Corner Record was received

and examined and filed

Signed

Title



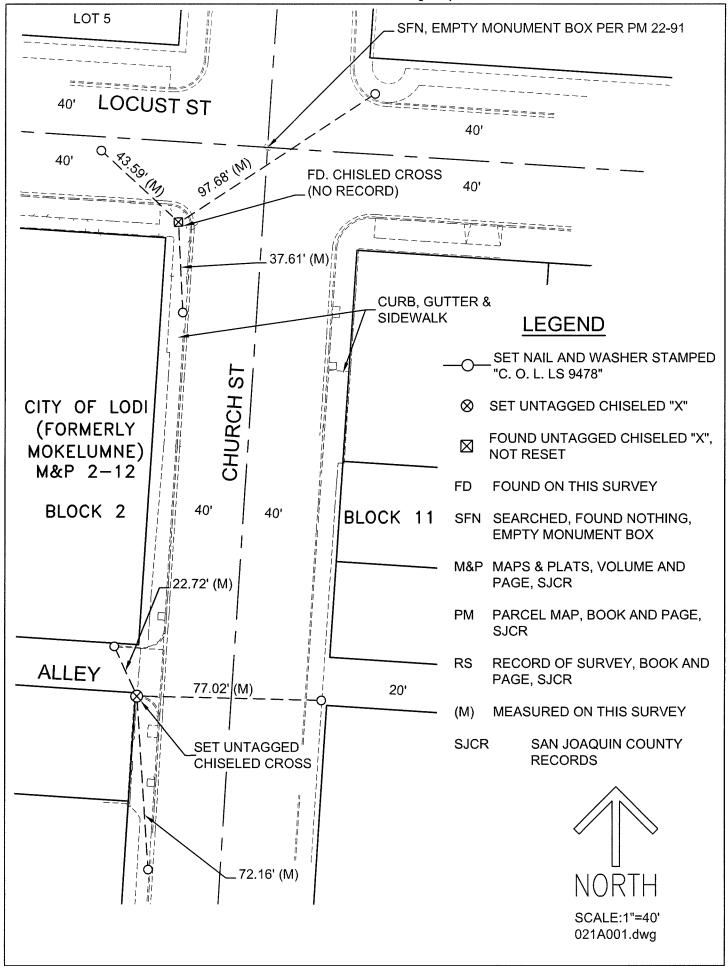

BPELSG-2016 PAGE 2 OF 2