## CR-21-248 CORNER RECORD Agency Index Document Number Lodi County of San Joaquin Property monuments at Pleasant Avenue & Vine Street (M&Ps 11-32 & 11-36) Brief Legal Description **CORNER TYPE COORDINATES (Optional)** E. Government Corner Control Elevation X Property X U.S. Survey Foot Meander Units Metric Rancho Other Horizontal Datum Zone Epoch Date Date of Survey August 23, 2021 Vertical Datum Complies with Public Resources Code §§8801-8819 Section 12, T.3N., R.6E. Complies with Public Resources Code §§8890-8902 M.D.B.&M. PLS Act Ref.: 8765(d) **X** 8771 8773 Other: Left as found Established Rebuilt Pre-Construction Corner/ Monument: Found and tagged Reestablished Referenced Post-Construction Narrative of corner identified and monument as found, set, reset, replaced, or removed: See sheet #2 for description(s): FOUND MONUMENTS AT NORTH CORNERS (PER M.&P. 11-36) AND SOUTH CORNERS (PER M.&P. 11-32) OF PLEASANT AVENUE AND VINE STREET ON LOT LINE PROJECTIONS. NO BOUNDARY ANALYSIS WAS PERFORMED. SURVEYOR'S STATEMENT This Corner Record was prepared by me or under my direction in conformance with NO. 9478 the Professional Land Surveyors' Act on October 12, 2021 9478 Signed P.L.S. or R.C.E. No.

**COUNTY SURVEYOR'S STATEMENT** 

and examined and filed October 28, 2021.

Signed Same E. Hart P.L.S. or R.C.

Title County Surveyor

**County Surveyor's Comment** 



DISTANCE (M) TABLE							
FD MONUMENT		FROM	DISTANCE	FROM2	DISTANCE2	FROM3	DISTANCE3
"A"	BENT 1 INCH IROD	"E"	146.42'	"F"	134.48'	"G"	49.54'
"B"	1 INCH IROD	"E"	138.86'	"F"	88.70'	"G"	66.70'
"C"	1 INCH IROD	"E"	88.88'	"F"	76.42'	"G"	109.36'
"D"	1 INCH IROD	"E"	99.84'	"F"	126.29'	"G"	99.39'

## **LEGEND**

FOUND MONUMENT AS NOTED IN TABLE (NO TAG) PER CR-21-030

FOUND NAIL AND WASHER STAMPED "C. O. L. LS 9478" PER CR-21-030

FD FOUND ON THIS SURVEY

SFN SEARCHED, FOUND NOTHING


M&P MAPS & PLATS, VOLUME AND PAGE, SAN JOAQUIN COUNTY RECORDS

RS RECORD OF SURVEY, BOOK AND PAGE, SAN JOAQUIN COUNTY RECORDS

(M) MEASURED ON THIS SURVEY

IROD IRON ROD, CALLED AXLE PER M&P 11-32, SAN JOAQUIN COUNTY RECORDS

CR (1) CORNER RECORD 17-297, SAN JOAQUIN COUNTY COUNTY SURVEYOR'S RECORDS

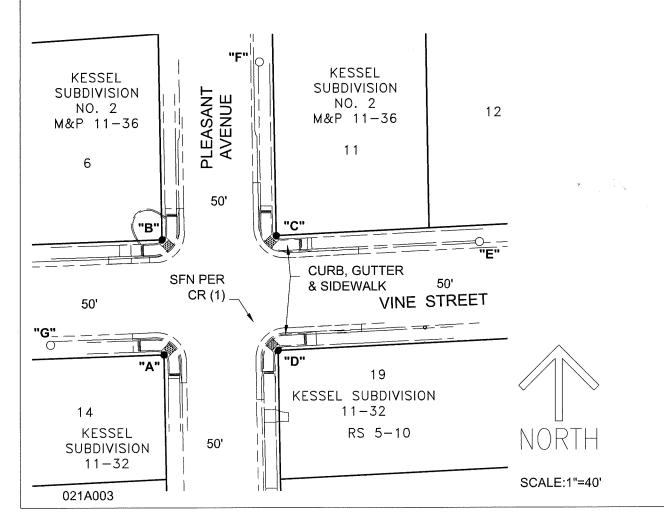

BPELSG-2016 PAGE 2 OF 2