


# CORNER RECORD

Agency Index CR-22-036  
Document Number \_\_\_\_\_

City of Stockton County of San Joaquin, California  
Brief Legal Description Found monument as noted, referenced and left as found.

### CORNER TYPE

### COORDINATES (Optional)

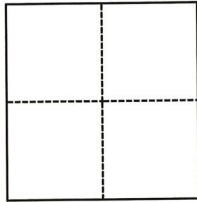

- Government Corner
- Meander
- Rancho
- Control
- Property
- Other

Date of Survey September 12, 2020

N. \_\_\_\_\_ E. \_\_\_\_\_  
 Elevation \_\_\_\_\_  
 Units  Metric  U.S. Survey Foot  
 Horizontal Datum \_\_\_\_\_  
 Zone \_\_\_\_\_ Epoch Date \_\_\_\_\_  
 Vertical Datum \_\_\_\_\_  
 Complies with Public Resources Code §§8801-8819  
 Complies with Public Resources Code §§8890-8902

PLS Act Ref.:  8765(d)  8771  8773  Other:  
 Corner/Monument:  Left as found  Established  Rebuilt  Pre-Construction  
 Found and tagged  Reestablished  Referenced  Post-Construction

Narrative of corner identified and monument as found, set, reset, replaced, or removed:  
 See sheet #2 for description(s):

Found a cut cross in the concrete sidewalk near the northwest return at the intersection of Miner Ave and Grant St. Set four (4) reference points, as noted on the reverse, outside of the construction limits.

### SURVEYOR'S STATEMENT

This Corner Record was prepared by me or under my direction in conformance with  
 the Professional Land Surveyors' Act on October 2, 2020  
 Signed *James N. Landrum* P.L.S. or R.C.E. No. 5837



### COUNTY SURVEYOR'S STATEMENT


This Corner Record was received February 1, 2022  
 and examined and filed February 14, 2022  
 Signed *James E. Hart* P.L.S. or R.C.E. No. 8657  
 Title County Surveyor



County Surveyor's Comment

LEGEND:

- FOUND CUT CROSS IN CONCRETE WALK
- SET REFERENCE POINT, CUT CROSS IN CONCRETE WALK, UNLESS OTHERWISE NOTED.

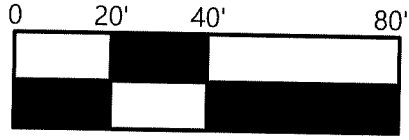

SCALE 1" = 40'

