


# CORNER RECORD

Agency Index CR-22-037  
Document Number \_\_\_\_\_

City of Stockton County of San Joaquin, California  
Brief Legal Description Found monument as noted, referenced and left as found.

## CORNER TYPE

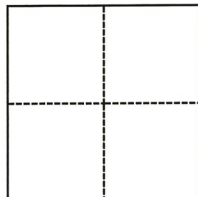

- ☐ Government Corner ☐ Control  
☐ Meander ☒ Property  
☐ Rancho ☐ Other

Date of Survey September 12, 2020

## COORDINATES (Optional)

N. \_\_\_\_\_ E. \_\_\_\_\_  
Elevation \_\_\_\_\_  
Units ☐ Metric ☐ U.S. Survey Foot  
Horizontal Datum \_\_\_\_\_  
Zone \_\_\_\_\_ Epoch Date \_\_\_\_\_  
Vertical Datum \_\_\_\_\_  
☐ Complies with Public Resources Code §§8801-8819  
☐ Complies with Public Resources Code §§8890-8902

PLS Act Ref.: ☐ 8765(d) ☒ 8771 ☐ 8773 ☐ Other:  
Corner/  
Monument: ☒ Left as found ☐ Established ☐ Rebuilt ☒ Pre-Construction  
☐ Found and tagged ☐ Reestablished ☒ Referenced ☐ Post-Construction

Narrative of corner identified and monument as found, set, reset, replaced, or removed:

☒ See sheet #2 for description(s):

Found a cut cross in the concrete sidewalk near the northwest return at the intersection of Miner Ave and Grant St. Set four (4) reference points, as noted on the reverse, outside of the construction limits.

## SURVEYOR'S STATEMENT

This Corner Record was prepared by me or under my direction in conformance with

the Professional Land Surveyors' Act on January 31, 2022

Signed James N. Landrum P.L.S. or R.C.E. No. 5837



## COUNTY SURVEYOR'S STATEMENT

This Corner Record was received February 1, 2022

and examined and filed February 14, 2022

Signed James E. Hart P.L.S. or R.C.E. No. 8657


Title County Surveyor

County Surveyor's Comment



LEGEND:

- FOUND CUT CROSS IN CONCRETE WALK
- SET REFERENCE POINT, CUT CROSS IN CONCRETE WALK, UNLESS OTHERWISE NOTED.

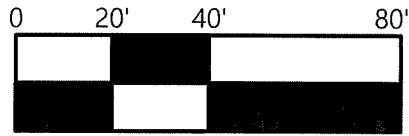

SCALE 1" = 40'

