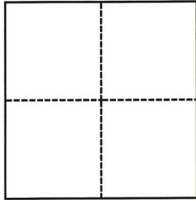


# CORNER RECORD

Agency Index CR-22-038

Document Number \_\_\_\_\_

City of Stockton County of San Joaquin, CaliforniaBrief Legal Description Found monument as noted, referenced and left as found.**CORNER TYPE****COORDINATES (Optional)**

- Government Corner     Control  
 Meander                     Property  
 Rancho                          Other

N. \_\_\_\_\_ E. \_\_\_\_\_

Elevation \_\_\_\_\_

Units  Metric  U.S. Survey Foot

Horizontal Datum \_\_\_\_\_

Zone \_\_\_\_\_ Epoch Date \_\_\_\_\_

Date of Survey September 12, 2020

Vertical Datum \_\_\_\_\_

 Complies with Public Resources Code §§8801-8819 Complies with Public Resources Code §§8890-8902PLS Act Ref.:  8765(d)  8771  8773  Other:

Corner/  
 Monument:  Left as found  Established  Rebuilt  Pre-Construction  
 Found and tagged  Reestablished  Referenced  Post-Construction

Narrative of corner identified and monument as found, set, reset, replaced, or removed:

 See sheet #2 for description(s):

Found a cut cross in the southerly sidewalk of Miner Ave approximately 100' east of Grant St. Set four (4) reference points, as noted on the reverse, outside of the construction limits.

**SURVEYOR'S STATEMENT**

This Corner Record was prepared by me or under my direction in conformance with


the Professional Land Surveyors' Act on January 31, 2022Signed James N. Landrum P.L.S. or R.C.E. No. 5837**COUNTY SURVEYOR'S STATEMENT**This Corner Record was received February 1, 2022and examined and filed February 14, 2022Signed James E. Hart P.L.S. or R.C.E. No. 8657Title County Surveyor**County Surveyor's Comment**

GRANT ST

MINER AVE

LEGEND:

- FOUND CUT CROSS IN CONCRETE WALK
- SET REFERENCE POINT, CUT CROSS IN CONCRETE WALK, UNLESS OTHERWISE NOTED.

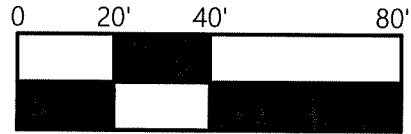

SCALE 1" = 40'

