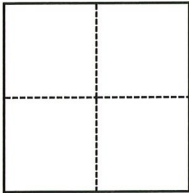


CORNER RECORD

Agency Index

CR-22-061

Document Number

City of Manteca County of San Joaquin, CaliforniaBrief Legal Description North half (N 1/2) Section 31, T.1S., R.7E., M.D.B. & M.**CORNER TYPE****COORDINATES (Optional)**

- ☐ Government Corner ☐ Control
☐ Meander ☒ Property
☐ Rancho ☐ Other

Date of Survey November 19, 2021

N. _____ E. _____

Elevation _____

Units ☐ Metric ☒ U.S. Survey Foot

Horizontal Datum _____

Zone _____ Epoch Date _____

Vertical Datum _____

☐ Complies with Public Resources Code §§8801-8819☐ Complies with Public Resources Code §§8890-8902

PLS Act Ref.:

☐ 8765(d)☒ 8771☐ 8773☐ Other:Corner/
Monument:☐ Left as found☐ Established☐ Rebuilt☐ Pre-Construction☐ Found and tagged☒ Reestablished☒ Referenced☒ Post-Construction

Narrative of corner identified and monument as found, set, reset, replaced, or removed:

☒ See sheet #2 for description(s):**SURVEYOR'S STATEMENT**

This Corner Record was prepared by me or under my direction in conformance with

the Professional Land Surveyors' Act on January 11, 2022

Signed

P.L.S. or R.C.E. No.

8159**COUNTY SURVEYOR'S STATEMENT**

This Corner Record was received

February 10, 2022

and examined and filed

February 24, 2022

Signed

P.L.S. or R.C.E. No.


8657

Title

County Surveyor

County Surveyor's Comment

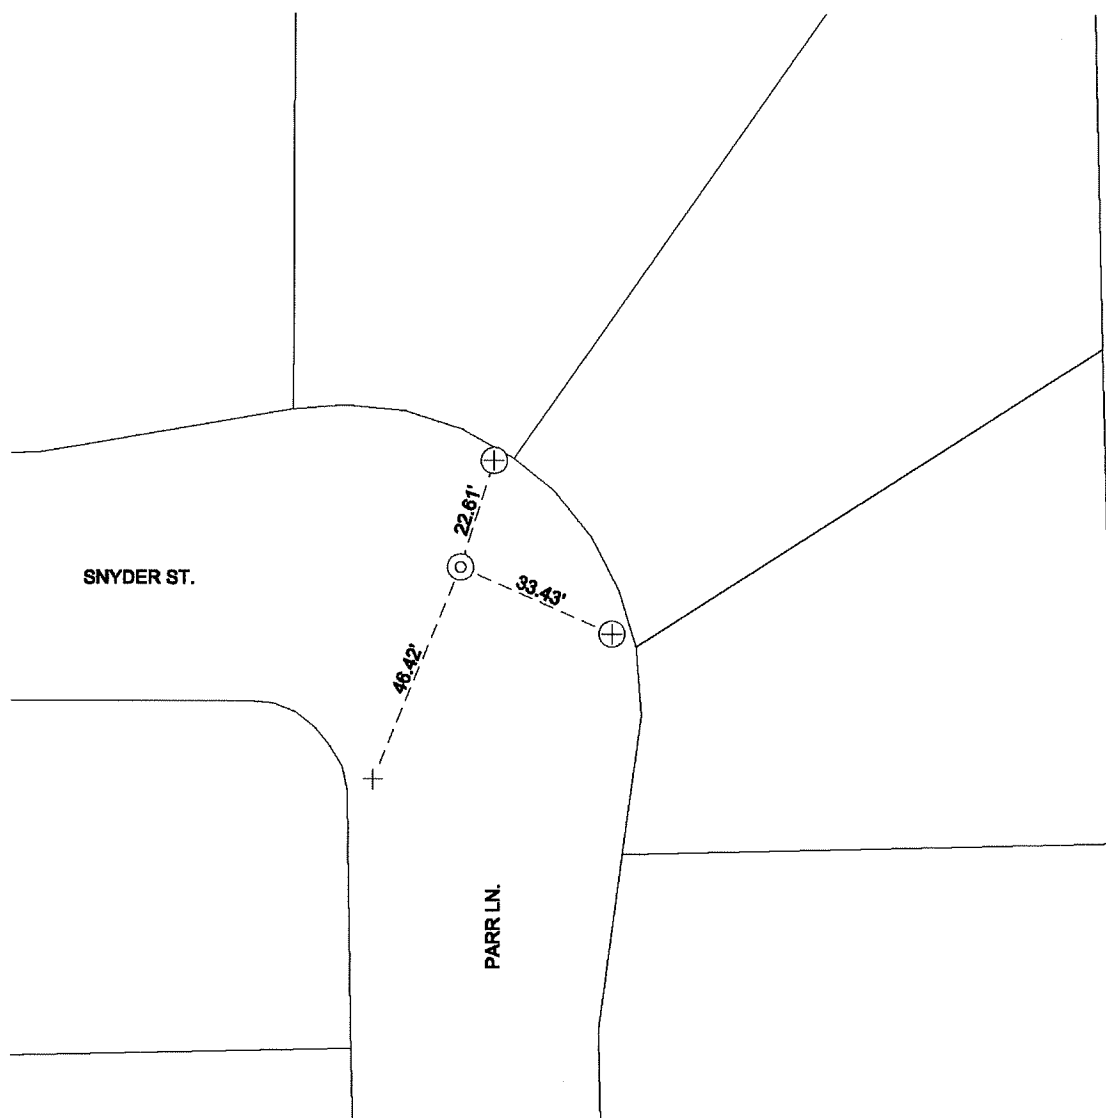

**NOTES:**

- ⊙ SET MONUMENT: 3/4" X 24" IRON PIPE STAMPED L.S. #8159 WITH PLASTIC CAP IN MONUMENT WELL.
- + FOUND SAWCUT "+" IN CONCRETE ON TOP OF CURB PER CR 21-177
- ⊕ FOUND SAWCUT "+" ON SIDEWALK PER CR 21-177
- CR CORNER RECORD, SAN JOAQUIN COUNTY SURVEYOR'S RECORDS

**NOT TO SCALE**