


# CORNER RECORD

Agency Index: CR-22-070  
 Document Number: \_\_\_\_\_  
 County of SAN JOAQUIN, California

City of STOCKTON  
 Brief Legal Description MONUMENTS AT THE INTERSECTION OF NORTH CALIFORNIA STREET AND EAST LINDSAY STREET.

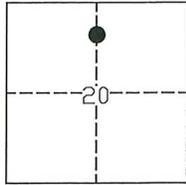

CAMPO DE LOS FRANCESES

### CORNER TYPE

- Government Corner     Control  
 Meander                     Property  
 Rancho                          Other

Date of Survey 1-20-2022

### COORDINATES (Optional)

N. \_\_\_\_\_ E. \_\_\_\_\_  
 Elevation \_\_\_\_\_  
 Units     Metric     U.S. Survey Foot  
 Horizontal Datum \_\_\_\_\_  
 Zone \_\_\_\_\_ Epoch Date \_\_\_\_\_  
 Vertical Datum \_\_\_\_\_  
 Complies with Public Resources Code §§8801-8819  
 Complies with Public Resources Code §§8890-8902

PLS Act Ref:     8765(d)             8771             8773             Other:  
 Corner/  
 Monument:     Left as found             Established             Rebuilt             Pre-Construction  
                    Found and Tagged         Reestablished             Referenced             Post-Construction

Narrative of corner identified and monument as found, set, reset, replaced, or removed:

See sheet #2 for description(s):

FOUND ONE (1) CHISELED CROSS AT THE NORTHWEST CORNER OF THE INTERSECTION OF NORTH CALIFORNIA STREET AND EAST LINDSAY STREET; SET FOUR (4) NAILS WITH BRASS TAG STAMPED "L.S. 6953" AS WITNESS CORNERS, ALL AS SHOWN ON PAGE 2.

### SURVEYOR'S STATEMENT

This Corner Record was prepared by me or under my direction in conformance with the Land Surveyors' Act on JANUARY 27, 2022,

Signed [Signature] P.L.S. or R.C.E. Number 6953



### COUNTY SURVEYOR'S STATEMENT

This Corner Record was received February 1, 2022


and examined and filed February 24, 2022

Signed James E. Hart P.L.S. or R.C.E. No: 8657

Title County Surveyor



County Surveyor's Comment \_\_\_\_\_

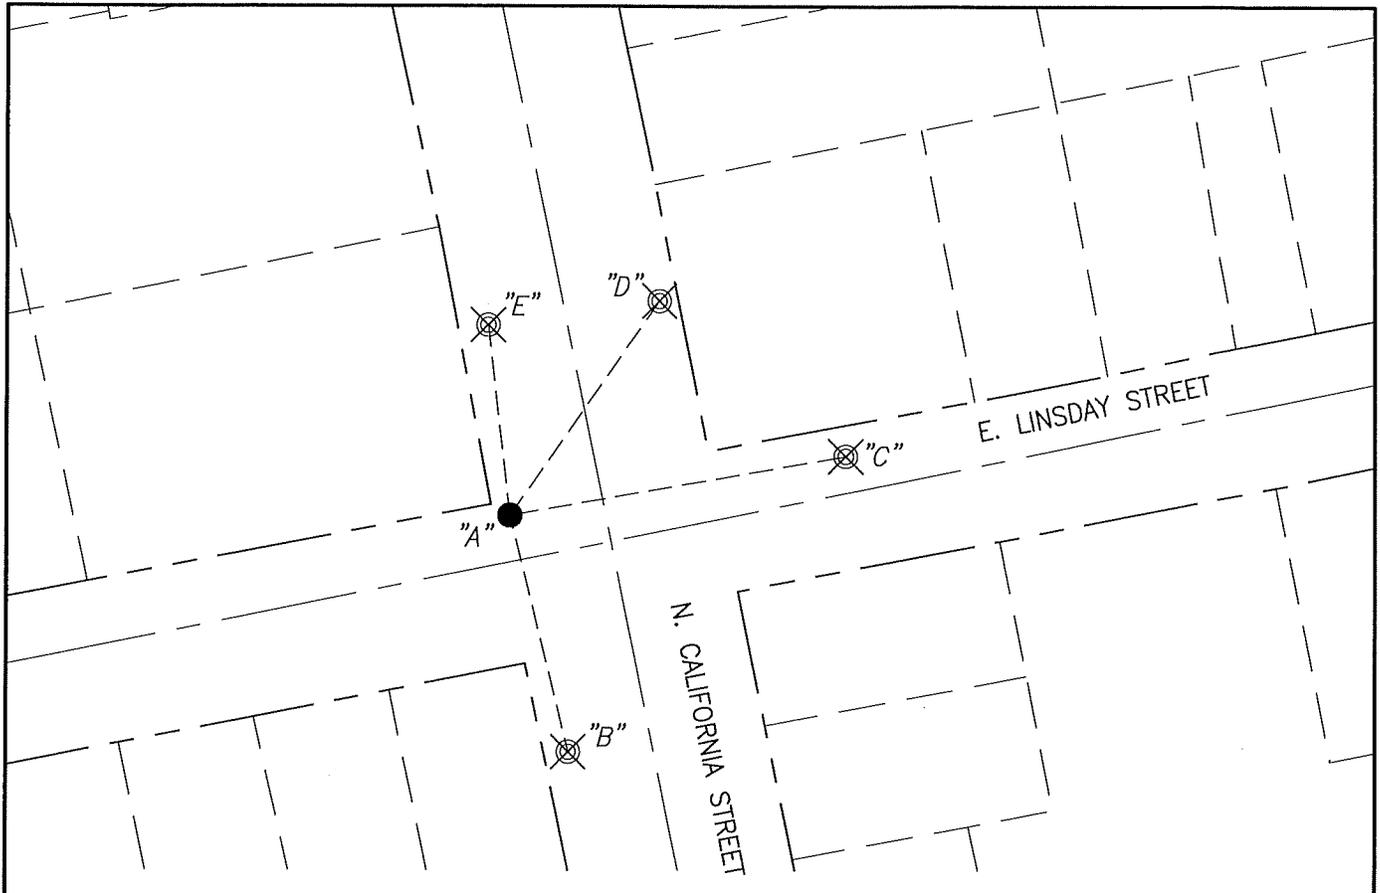

BS-@-FS	☒	FS DISTANCE
B-A-B	00°00'00"	90.02'(M)
B-A-C	280°32'50"	125.15'(M)
B-A-D	226°31'36"	96.49'(M)
B-A-E	195°05'50"	73.82'(M)



NOT TO SCALE

**LEGEND:**

- ☒ SET NAIL WITH BRASS TAG STAMPED "L.S. 6953"
- FOUND CHISELED CROSS
- S.J.C.R. SAN JOAQUIN COUNTY RECORDS
- (M) MEASURED DISTANCE. ALL DISTANCES ARE MEASURED UNLESS NOTED OTHERWISE.