
CORI	NER REC	ORD	Agency Index	CR-22-107
	tion Oro Avonuo			n, California
Brief Legal Descrip	tion Oro Avenue	66, C.M. Weber C		
				DIMATES (Outlines)
CORNER TYPE			COORDINATES (Optional)  NE	
	Government Corner	Control	Elevation.	E.
	Meander	Property	Units Metric	U.S. Survey Foot X
	Rancho	Other X		184
			ZoneE	och Date
į.	Date of Survey	ctober 21, 2021	Vertical Datum	
				c Resources Code §§8801-8819 c Resources Code §§8890-8902
PLS Act Ref.:		X 8771	8773	Other:
Corner/	Left as found	Established	X Rebuilt	☐ Pre-Construction
Monument:	☐ Found and tagged	Reestablished	Referenced	X Post-Construction
				SIONAL LANDS
	SURVEYOR'S ST	ATEMENT		TO LO L. MADE
This Corner Record was prepared by me or under my direction in conformance with				S S S S S S S S S S S S S S S S S S S
the Professional Land Surveyor's Act on December 17, 2021				IICENSE JZ
Signed Jame	Z Hout	_ P.L.S. o <del>r R.C.E</del> . No. <sub>-</sub>	8657	No. 8657
	COUNTY SURVEYOR	S STATEMENT		OF CALIFORNIA
This Corner Record was	received <u>February</u> March 1,	ary 2, 2022	)	111111111111111111111111111111111111111
and examined and filed	March 1.	2022		CSOS F. VISC
Signed James	E Hart	P.L.S. <del>or R.G.E</del> . No	8657	S S S S S S S S S S S S S S S S S S S
TitleC	County Surveyor			ILC FNSF R
County Surveyor's C	comment			No. 8657
				TE OF CALLED

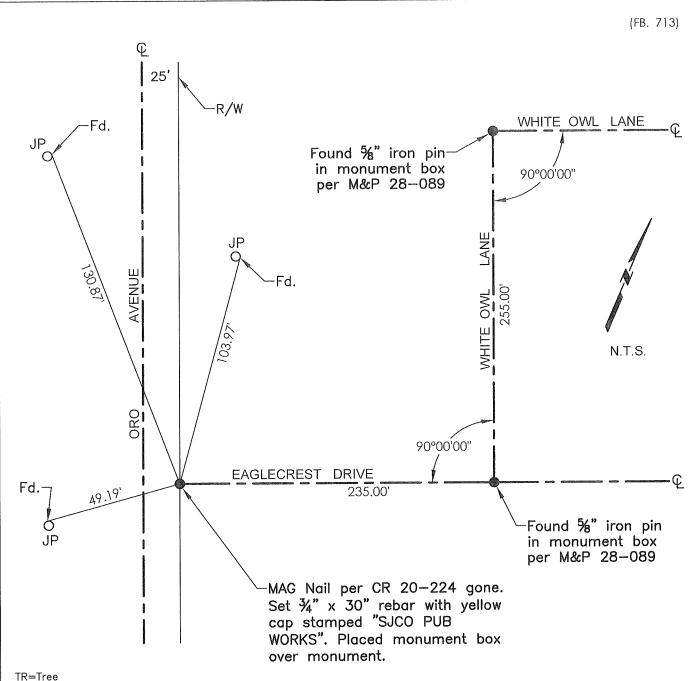

MB=Mailbox BM=Bench Mark EP=Edge of Pavement YL=Yellow Line FH=Fire Hydrant CR=Corner Record FP=Fence Post JP=Joint Pole LP=Light Pole PP=Power Pole GP=Guy Pole SP=Service Pole TP=Telephone Pole S.F.N.=Searched Found Nothing N.T.S.=Not To Scale M&P=Maps & Plats PM=Parcel Map RS=Record of Survey FB=Field Book N=North SDI=Storm Drain Inlet TOC=Top of Curb PCC=Portland Cement Concrete

Set=Conc. Nail with Brass Washer stamped
"S.J. Co.", unless otherwise noted
Fd.=Found Conc. Nail with Brass Washer stamped
"S.J. Co.", unless otherwise noted
Note: Found Monuments are not tagged unless otherwise noted.

"No attempt was made to verify the Monument(s)"