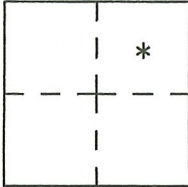


CORNER RECORD

Agency Index CR-22-116

Document Number _____

City of Ripon County of San Joaquin, CaliforniaBrief Legal Description Lot 7, Block 6 Sunnyside Add'n to Twn of Ripon 4 M&P 46**CORNER TYPE****COORDINATES (Optional)**

Government Corner Control
 Meander Property
 Rancho Other

N. _____ E. _____

Elevation. _____

Units Metric U.S. Survey Foot

Horizontal Datum _____

Zone _____ Epoch Date _____

Date of Survey June 07, 2019

Vertical Datum _____

 Complies with Public Resources Code §§8801-8819 Complies with Public Resources Code §§8890-8902S.30 T.2S.,R8E
M.D.M.PLS Act Ref.: 8765(d) 8771 8773 Other:Corner/Monument: Left as found Established Rebuilt Pre-Construction Found and tagged Reestablished Referenced Post-Construction

Narrative of corner identified and monument as found, set, reset, replaced, or removed:

 See sheet #2 for description(s):

The west chiseled cross shown on Book 28 of Surveys, page 30, was lost during sidewalk construction. Using the 1/4" drill holes in the sidewalk on the north side of First Street, and the "no dumping" buttons, from the pre-construction Corner Record, I replaced said west cross following the sidewalk construction.


SURVEYOR'S STATEMENT

This Corner Record was prepared by me or under my direction in conformance with

the Professional Land Surveyor's Act on June 07, 2019Signed [Signature] P.L.S. or R.C.E. No. PLS 5443**COUNTY SURVEYOR'S STATEMENT**This Corner Record was received March 16, 2022and examined and filed April 4, 2022Signed James E. Hart P.L.S. or R.C.E. No. 8657Title County Surveyor

County Surveyor's Comment _____



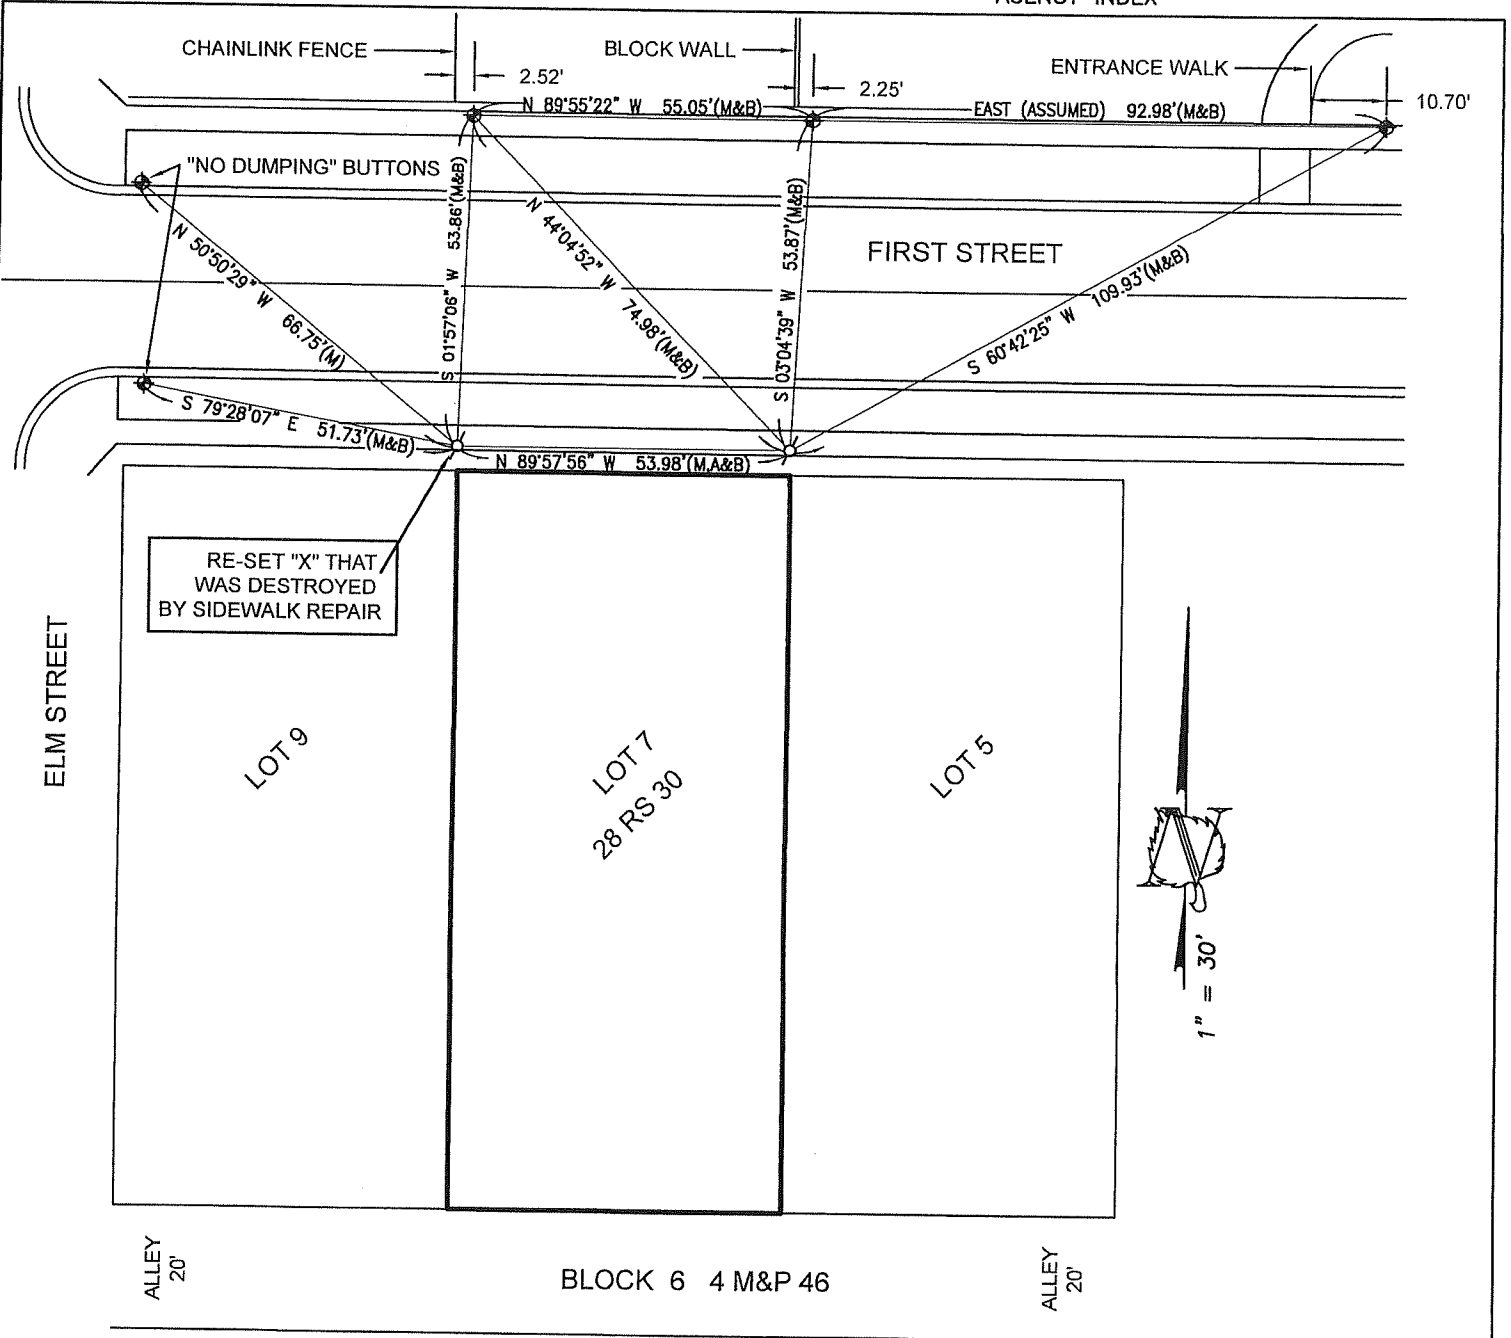


RE-SET "X" THAT
WAS DESTROYED
BY SIDEWALK REPAIR



- (A) BOOK 28 OF SURVEYS, PAGE 30
- (B) PRE-CONSTRUCTION CORNER RECORD No. _____
- M&P MAPS AND PLATS
- RS RECORD OF SURVEY
- ALL REFERENCES ARE SAN JOAQUIN COUNTY RECORDS

NOTE:
THE PURPOSE OF THIS CORNER RECORD IS TO RESET AND REFERENCE THE CHISELED CROSS IN THE SIDEWALK AS SHOWN ON REFERENCE (A) THAT WAS DESTROYED AFTER SIDEWALK REPAIR.

- ⊙ FOUND CHISELED CROSS ON 4' OFFSET IN SIDEWALK PER REFERENCE (A) UNLESS OTHERWISE NOTED
- ⊙ FD A 1/4" DRILL HOLE IN SIDEWALK FOR REFERENCE MARK TO THE FOUND MONUMENTS OF RECORD. (FROM REFERENCE B) UNLESS OTHERWISE NOTED.

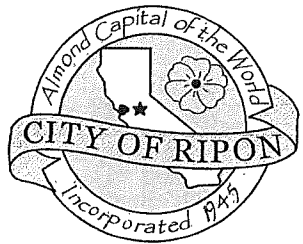

AFTER CONSTRUCTION