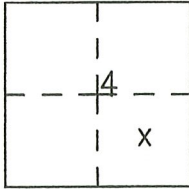


# CORNER RECORD

Agency Index CR-22-119

Document Number \_\_\_\_\_

City of Escalon County of San Joaquin, CaliforniaBrief Legal Description Lot 6 of STEPPINGSTONE HOMES Book 29 Maps & Plats, Page 43T.2S., R.9E.  
M.D.M.**CORNER TYPE**
 Government Corner  Control   
 Meander  Property   
 Rancho  Other 
Date of Survey February 16, 2022**COORDINATES (Optional)**

N. \_\_\_\_\_ E. \_\_\_\_\_

Elevation. \_\_\_\_\_

Units Metric  U.S. Survey Foot 

Horizontal Datum \_\_\_\_\_

Zone \_\_\_\_\_ Epoch Date \_\_\_\_\_

Vertical Datum \_\_\_\_\_

 Complies with Public Resources Code §§8801-8819 Complies with Public Resources Code §§8890-8902PLS Act Ref.:  8765(d)  8771  8773  Other:Corner/ Monument:  Left as found  Established  Rebuilt  Pre-Construction Found and tagged  Reestablished  Referenced  Post-Construction

Narrative of corner identified and monument as found, set, reset, replaced, or removed:

 See sheet #2 for description(s):

Found several monuments from record maps and others which are unreferenced. Reestablished the most westerly corner of Lot 6 of STEPPINGSTONE HOMES as shown on the map page of this Corner Record.


**SURVEYOR'S STATEMENT**

This Corner Record was prepared by me or under my direction in conformance with

the Professional Land Surveyor's Act on February 16, 2022Signed [Signature] P.L.S. or R.C.E. No. PLS 5443**COUNTY SURVEYOR'S STATEMENT**This Corner Record was received March 16, 2022and examined and filed April 7, 2022Signed [Signature] P.L.S. or R.C.E. No. 8657Title County Surveyor

County Surveyor's Comment \_\_\_\_\_



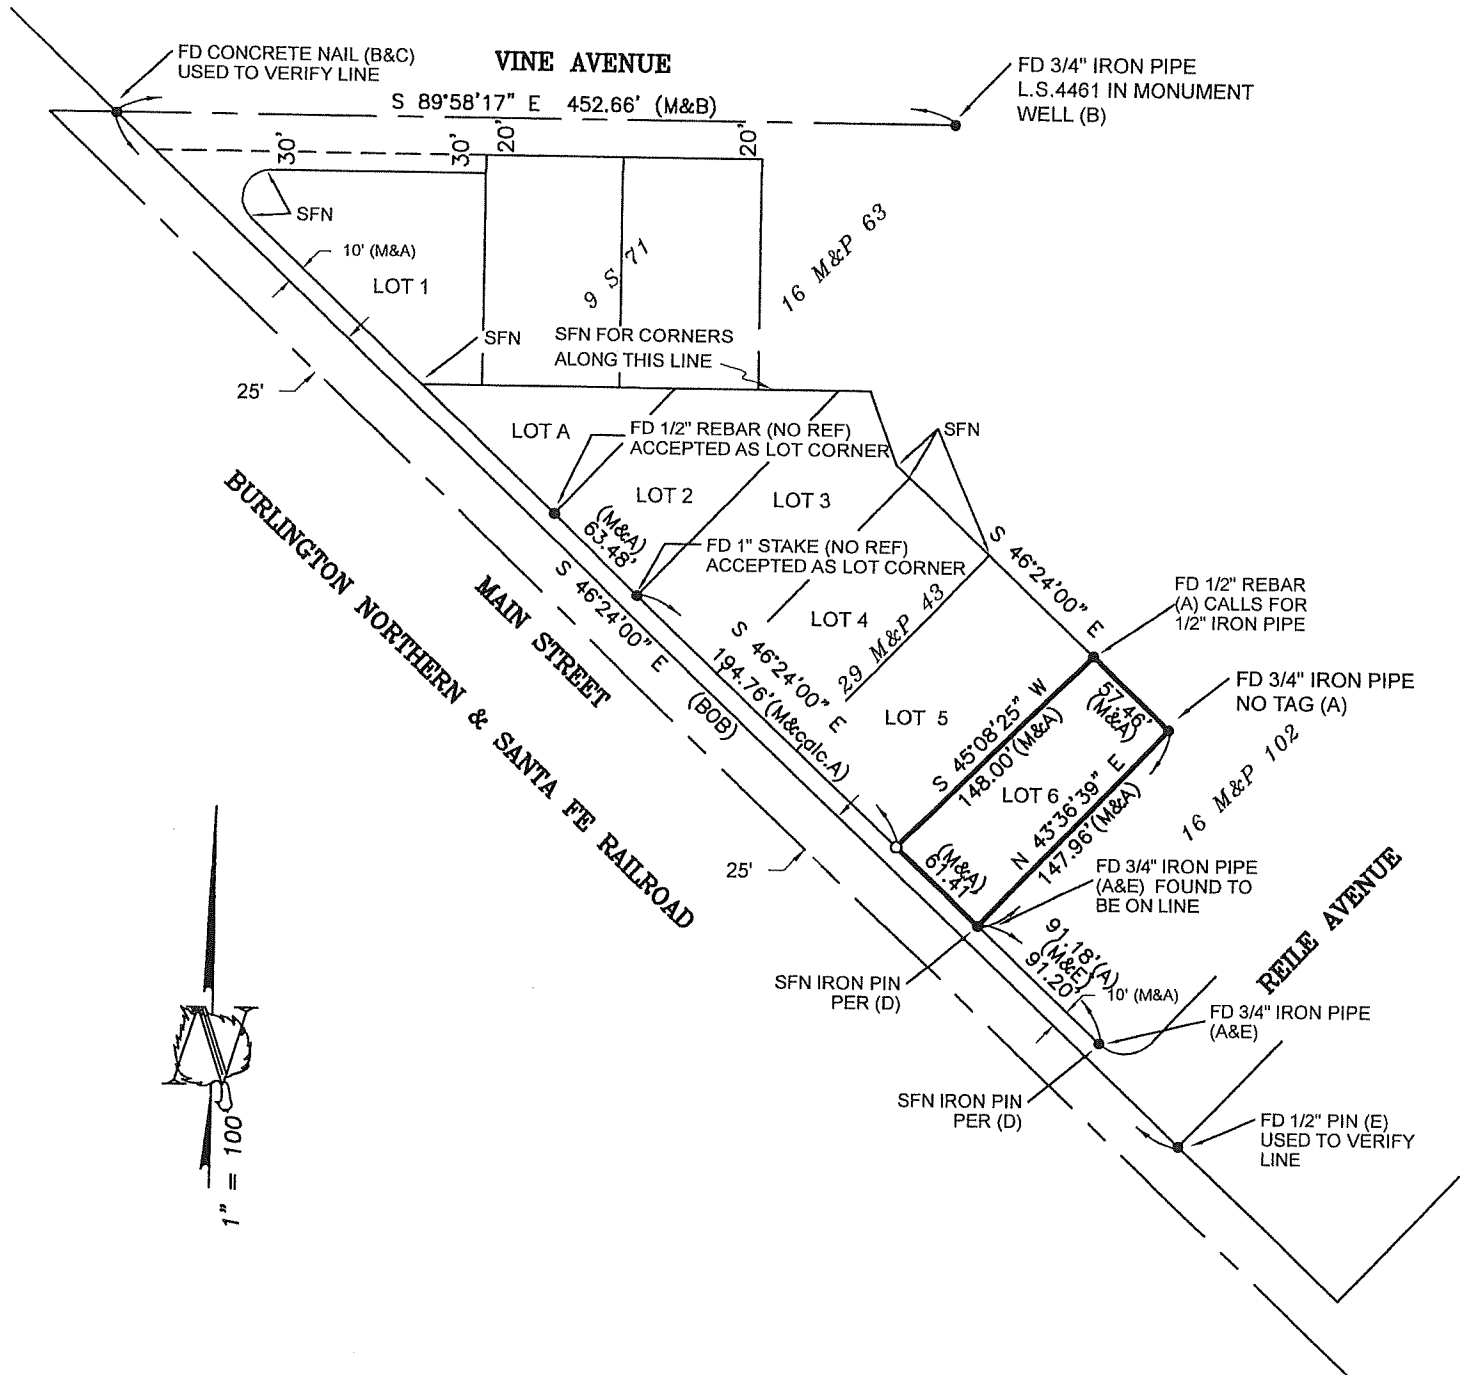

- (BOB) BASIS OF BEARINGS FROM (A)
- (A) BOOK 29 OF MAPS & PLATS, PAGE 43 SJCR
- (B) BOOK 39 OF SURVEYS, PAGE 55 SJCR
- (C) BOOK 27 OF MAPS & PLATS, PAGE 66
- (D) BOOK 16 OF MAPS & PLATS, PAGE 102
- (E) BOOK 32 OF SURVEYS, PAGE 147

- INDICATES FOUND MONUMENT AS NOTED
- INDICATES SET 3/4" IRON PIPE 30" LONG WITH TAG L.S. 5443

LOT 6 DENOTES LOT FROM REFERENCE A  
 SFN DENOTES SEARCHED FOUND NOTHING  
 (BOB) DENOTES BASIS OF BEARINGS  
 SJCR SAN JOAQUIN COUNTY RECORDS  
 (calc.) DENOTES INFORMATION CALCULATED FROM RECORD

# CORNER RECORD