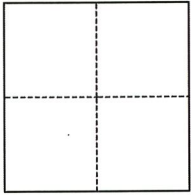


CORNER RECORD

Agency Index CR-22-136
 Document Number _____

City of STOCKTON County of SAN JOAQUIN, California
 Brief Legal Description CUT "X" MONUMENT AT SE CORNER MINER AVE AND SAN JOAQUIN ST.

CORNER TYPE		COORDINATES (Optional)	
	<input type="checkbox"/> Government Corner	<input type="checkbox"/> Control	N. _____ E. _____
	<input type="checkbox"/> Meander	<input checked="" type="checkbox"/> Property	Elevation _____
	<input type="checkbox"/> Rancho	<input type="checkbox"/> Other	Units <input type="checkbox"/> Metric <input type="checkbox"/> U.S. Survey Foot
	Date of Survey <u>02/01/2022</u>		Horizontal Datum _____
		Zone _____ Epoch Date _____	Vertical Datum _____
		<input type="checkbox"/> Complies with Public Resources Code §§8801-8819	<input type="checkbox"/> Complies with Public Resources Code §§8890-8902

PLS Act Ref.:	<input type="checkbox"/> 8765(d)	<input checked="" type="checkbox"/> 8771	<input type="checkbox"/> 8773	<input type="checkbox"/> Other:
Corner/ Monument:	<input type="checkbox"/> Left as found	<input type="checkbox"/> Established	<input type="checkbox"/> Rebuilt	<input type="checkbox"/> Pre-Construction
	<input type="checkbox"/> Found and tagged	<input checked="" type="checkbox"/> Reestablished	<input checked="" type="checkbox"/> Referenced	<input checked="" type="checkbox"/> Post-Construction

Narrative of corner identified and monument as found, set, reset, replaced, or removed:
 See sheet #2 for description(s):
SET A CUT CROSS IN THE CONCRETE SIDEWALK OF SOUTHEAST CURB RETURN AT THE INTERSECTION OF MINER AVE AND SAN JOAQUIN ST. OLD MONUMENT WAS REMOVED DURING CONSTRUCTION AND WAS RESET AT ITS ESTABLISHED LOCATION AFTER CONSTRUCTION USING THE FOUND FOUR (4) REFERENCE POINTS PER CR22-043 AS NOTED ON THE REVERSE.

SURVEYOR'S STATEMENT

This Corner Record was prepared by me or under my direction in conformance with the Professional Land Surveyors' Act on MARCH 31, 2022.
 Signed *James N. Landrum* P.L.S. or R.C.E. No. 5837




COUNTY SURVEYOR'S STATEMENT



This Corner Record was received April 4, 2022
 and examined and filed April 14, 2022.
 Signed *James E. Hart* P.L.S. or R.C.E. No. 8657
 Title County Surveyor

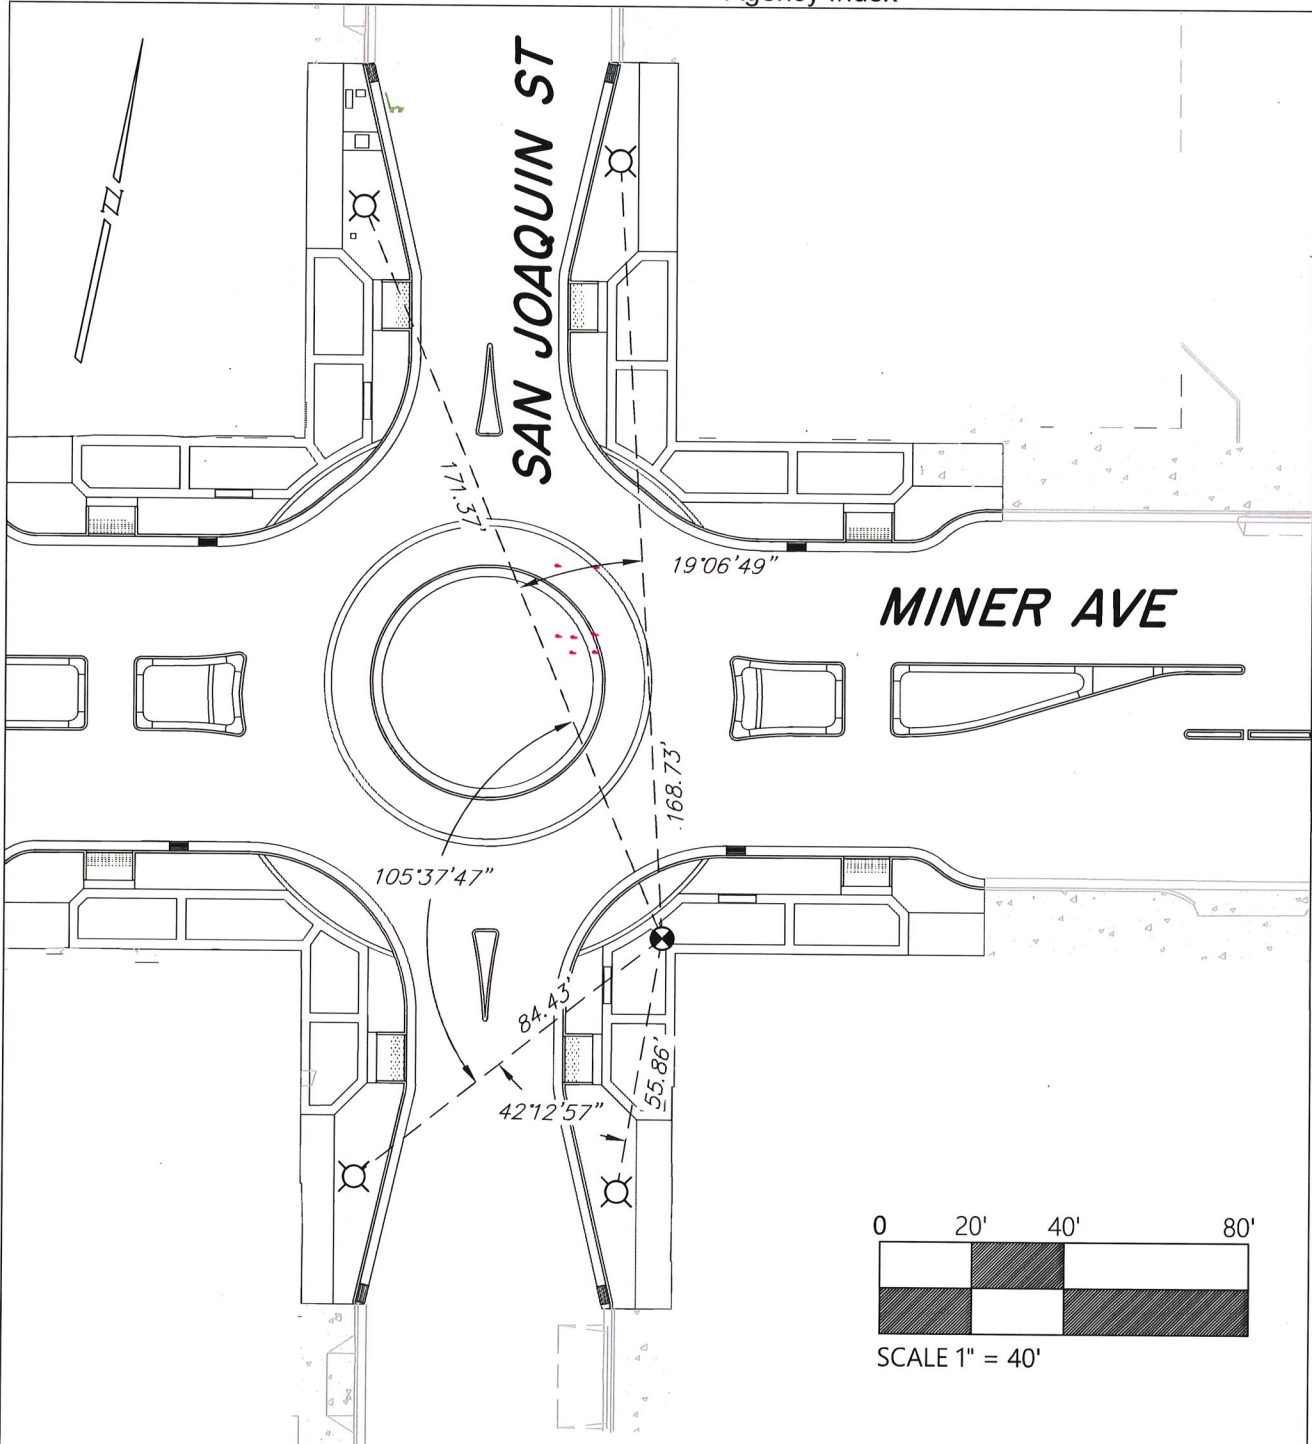

County Surveyor's Comment _____



LEGEND

-  SET CUT "X" IN CONCRETE WALK
-  FOUND REFERENCE POINT, CUT "X" IN CONCRETE CURB UNLESS OTHERWISE NOTED.

NOTES

1. ALL DISTANCES AND ANGLES SHOWN ABOVE ARE BOTH MEASURED AND RECORD PER CR 22-043.
2. NOTE THAT BEARINGS SHOWN ARE FOR ANGULAR CONTROL FROM LOCAL CONSTRUCTION SURVEY DATA.